

1 LOCATION OF WATER WELL: County: Rice	Fraction <u>NO</u> 1/4 NC 1/4 NE 1/4	Section Number 24	Township Number T 20 S	Range Number R 9 <u>E/W</u>
---	---	----------------------	---------------------------	--------------------------------


Distance and direction from nearest town or city street address of well if located within city?

Approximately 3 1/4 miles south and 3 1/4 miles west of Lyons

2 WATER WELL OWNER: RR#, St. Address, Box # : City, State, ZIP Code :	Kenneth Knight 1768 Avenue J Lyons, KS 67554	Board of Agriculture, Division of Water Resources Application Number: 26,032
---	--	---

3 LOCATE WELL'S LOCATION WITH AN "X" IN SECTION BOX:

4 DEPTH OF COMPLETED WELL: 16 ft. ELEVATION:

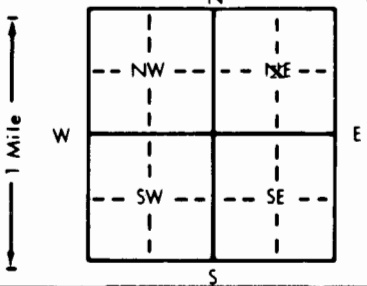

Depth(s) Groundwater Encountered 1. . . . . ft. 2. . . . . ft. 3. . . . . ft.

WELL'S STATIC WATER LEVEL . . . . . 15 . . . . . ft. below land surface measured on mo/day/yr . . . . . 8-11-98

Pump test data: Well water was . . . . . ft. after . . . . . hours pumping . . . . . gpm

Est. Yield . . . . . gpm: Well water was . . . . . ft. after . . . . . hours pumping . . . . . gpm

Bore Hole Diameter . . . . . in. to . . . . . ft., and . . . . . in. to . . . . . ft.

WELL WATER ~~TO BE~~ USED AS: 5 Public water supply 8 Air conditioning 11 Injection well  
1 Domestic 3 Feedlot 6 Oil field water supply 9 Dewatering 12 Other (Specify below)  
2 Irrigation 4 Industrial 7 Lawn and garden only 10 Monitoring well

Was a chemical/bacteriological sample submitted to Department? Yes . . . . . No . . . . . ; If yes, mo/day/yr sample was submitted

Water Well Disinfected? Yes . . . . . No

5 TYPE OF BLANK CASING USED:	5 Wrought iron	8 Concrete tile	CASING JOINTS: Glued . . . . . Clamped . . . . .
1 Steel	3 RMP (SR)	6 Asbestos-Cement	9 Other (specify below) Welded . . . . .
2 PVC	4 ABS	7 Fiberglass	Transite . . . . . Threaded . . . . .

Blank casing diameter . . . . . 16 . . . . . in. to . . . . . ft., Dia . . . . . in. to . . . . . ft., Dia . . . . . in. to . . . . . ft.

Casing height above land surface . . . . . 4' below . . . . . in., weight . . . . . lbs./ft. Wall thickness or gauge No. . . . .

TYPE OF SCREEN OR PERFORATION MATERIAL:	7 PVC	10 Asbestos-cement
1 Steel	3 Stainless steel	5 Fiberglass
2 Brass	4 Galvanized steel	6 Concrete tile
8 RMP (SR)	11 Other (specify) <u>NA</u>	12 None used (open hole)
9 ABS	12 None used (open hole)	

SCREEN OR PERFORATION OPENINGS ARE:	5 Gauzed wrapped	8 Saw cut	11 None (open hole)
1 Continuous slot	3 Mill slot	6 Wire wrapped	9 Drilled holes
2 Louvered shutter	4 Key punched	7 Torch cut	10 Other (specify) <u>NA</u>

SCREEN-PERFORATED INTERVALS: From . . . . . 999 . . . . . ft. to . . . . . 999 . . . . . ft., From . . . . . ft. to . . . . . ft.

GRAVEL PACK INTERVALS: From . . . . . ft. to . . . . . ft., From . . . . . ft. to . . . . . ft.

6 GROUT MATERIAL:	1 Neat cement	2 Cement grout	3 Bentonite	4 Other . . . . .
-------------------	---------------	----------------	-------------	-------------------

Grout Intervals: From . . . . . 15 . . . . . ft. to . . . . . 4 . . . . . ft., From . . . . . ft. to . . . . . ft., From . . . . . ft. to . . . . . ft.

What is the nearest source of possible contamination:

1 Septic tank	4 Lateral lines	7 Pit privy	10 Livestock pens	14 Abandoned water well
2 Sewer lines	5 Cess pool	8 Sewage lagoon	11 Fuel storage	15 Oil well/Gas well
3 Watertight sewer lines	6 Seepage pit	9 Feedyard	12 Fertilizer storage	16 Other (specify below)
			13 Insecticide storage	None known

Direction from well?		LITHOLOGIC LOG	How many feet?		PLUGGING INTERVALS
FROM	TO		FROM	TO	
			16	15	Chlorinated sand
			15	4	Concrete grout
			4	0	Soil

7 CONTRACTOR'S OR LANDOWNER'S CERTIFICATION: This water well was (1) constructed, (2) reconstructed, or (3) plugged under my jurisdiction and was completed on (mo/day/year) . . . . . 8-11-98 . . . . . and this record is true to the best of my knowledge and belief. Kansas Water Well Contractor's License No. . . . . 185 . . . . . This Water Well Record was completed on (mo/day/yr) . . . . . 8-14-98 . . . . . under the business name of Clarke Well & Equipment, Inc. by (signature) Clarke W. Clarke

OFFICE USE ONLY  
T  
R  
EW  
SEC.  
1/4  
1/4  
1/4