


1 LOCATION OF WATER WELL:	Fraction	Section Number	Township Number	Range Number
County: <u>Rice</u>	<u>NE 1/4 SW 1/4 SE 1/4</u>	<u>24</u>	<u>20</u>	<u>9</u> SW

Distance and direction from nearest town or city street address of well if located within city?
2 3/4 South, 2 3/4 West of Lyons

2 WATER WELL OWNER: Gilbert- Stewart Operating
 RR #, St. Address, Box #: 1801 Broadway, Ste 450
 City, State, ZIP Code : Denver, Co. 80202 Board of Agriculture, Division of Water Resources
 Application Number: 20070260

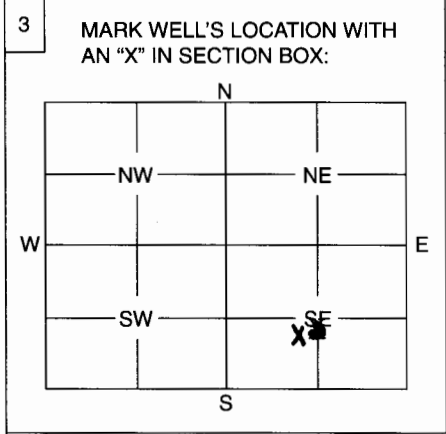

4 DEPTH OF WELL63..... ft.
 WELL'S STATIC WATER LEVEL 14 ~~X8~~ ft.
 WELL WAS USED AS:
 1 Domestic 5 Public Water Supply 9 Dewatering
 2 Irrigation 6 ~~Oil Field Water Supply~~ 10 Monitoring Well
 3 Feedlot 7 Domestic (Lawn & Garden) 11 Injection Well
 4 Industrial 8 Air Conditioning 12 Other

Was a chemical / bacteriological sample submitted to Department? Yes No X.....
 If yes, mo/day/yr sample was submitted

Water Well Disinfected: Yes HTH No

5 TYPE OF BLANK CASING USED:

1 Steel	3 RMP (SR)	5 Wrought	7 Fiberglass	9 Other (Specify below)
2 <u>PVC</u>	4 ABS	6 Asbestos-Cement	8 Concrete Tile	

Blank casing diameter5..... in. Was casing pulled? Yes No X.....
 Casing height above or below land surface36..... in. If yes, how much

6 GROUT PLUG MATERIAL: 1 Neat cement 2 Cement grout 3 Bentonite 4 Other hole plug.....
 Grout Plug Intervals: From ft. to ft., From ft. to ft., From 63 to 3 ft.

What is the nearest source of possible contamination:

1 Septic tank	6 Seepage pit	11 Fuel storage	16 Other (specify below)
2 Sewer lines	7 Pit privy	12 Fertilizer storage	<u>None</u>
3 Watertight sewer lines	8 Sewage lagoon	13 Insecticide storage	
4 Lateral lines	9 Feedyard	14 Abandoned water well	
5 Cess pool	10 Livestock pens	15 Oil well/Gas well	

Direction from well? How many feet?

FROM	TO	PLUGGING MATERIALS
63	3	Hole plug
3	0	Top soil

7 CONTRACTOR'S OF LANDOWNER'S CERTIFICATION: This water well was plugged under my jurisdiction and was completed on (mo/day/year)2-8-08..... and this record is true to the best of my knowledge and belief. Kansas Water Well Contractor's License No.134..... This Water Well Record was completed on (mo/day/year)2-11-08..... under the business name of Rosenkrantz-Bemis.....
 by (signature) [Signature]

INSTRUCTIONS: Use typewriter or ball point pen. Please press firmly and print clearly. Please fill in blanks, underline or circle the correct answers. Send top three copies to Kansas Department of Health and Environment, Bureau of Water, Geology Section, 1000 SW Jackson St., Ste. 420, Topeka, Kansas 66612-1367. Telephone: 785/296-5522. Send one to Water Well Owner and retain one for your records.