

WATER WELL PLUGGING RECORD Form WWC-5P

KSA 82a-1212 ID NO.

MW-1

1 LOCATION OF WATER WELL: Fraction NW 1/4 SE 1/4 NE 1/4 NE 1/4 Section Number 4 Township Number T 20 S Range Number 9 E W
 County: Rice


Street/Rural Address of Well Location; if unknown, distance & direction from nearest town or intersection: If at owner's address, check here 1/4 mile south of US 56 Highway and 10th Road; Rice County

Global Positioning Systems (GPS) information:
 Latitude: 38.345226 (in decimal degrees)
 Longitude: -98.314109 (in decimal degrees)
 Elevation: _____
 Horizontal Datum: WGS84, NAD83, NAD27
 Collection Method: _____

2 WATER WELL OWNER: CHS
 RR#, St. Address, Box #: 2000 S Main St
 City, State ZIP Code: McPherson, KS 67460

GPS unit (Make/Model: _____)
 Digital Map/Photo, Topographic Map, Land Survey
 Est. Accuracy: < 3 m, 3-5 m, 5-15 m, > 15 m

3 MARK WELL'S LOCATION WITH AN "X" IN SECTION BOX:

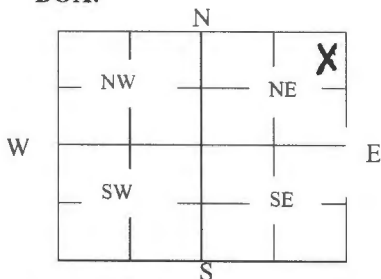

4 DEPTH OF WELL 21 ft.

WELL'S STATIC WATER LEVEL 6 ft

WELL WAS USED AS:

Domestic Public Water Supply Dewatering
 Irrigation Oil Field Water Supply Monitoring
 Feedlot Domestic (Lawn & Garden) Injection Well
 Industrial Air Conditioning Other _____

Was a chemical/bacteriological sample submitted to Department? Yes No

5 TYPE OF BLANK CASING USED:

Steel RMP (SR) Wrought Fiberglass Other (Specify below)
 PVC ABS Asbestos-Cement Concrete Tile

Blank casing diameter 2 in. Was casing pulled? Yes No If yes, how much all
 Casing height above or below land surface 36 in.

6 GROUT PLUG MATERIAL: Neat cement Cement grout Bentonite Other Top Soil

Grout Plug Intervals: From 0 ft. to 3 ft., From 3 ft. to 21 ft., From — ft. to — ft.

What is the nearest source of possible contamination:


Septic tank Seepage pit Fuel storage Other (specify below)
 Sewer lines Pit privy Fertilizer storage
 Watertight sewer lines Sewage lagoon Insecticide storage
 Lateral lines Feedyard Abandoned water well Direction from well? _____
 Cess pool Livestock pens Oil well/Gas well How many feet? _____

FROM	TO	PLUGGING MATERIALS	FROM	TO	PLUGGING MATERIALS
0	3	Top Soil			
3	21	Bentonite			

7 CONTRACTOR'S OR LANDOWNER'S CERTIFICATION: This water well was plugged under my jurisdiction and was completed on (mo/day/year) 7/1/2019 and this record is true to the best of my knowledge and belief. Kansas Water Well Contractor's License No. 710. This Water Well Record was completed on (mo/day/year) 7/3/2019 under the business name of Below Ground Surface, Inc. by (signature) Craig R. Hewitt


Send one white copy to Kansas Department of Health & Environment, Geology Section, 1000 SW Jackson Street, Ste. 420, Topeka, KS 66612-1367. Send one copy to WATER WELL OWNER and retain one for your records.

Visit us at <http://www.kdheks.gov/waterwell/index.html> Telephone 785-296-5524.

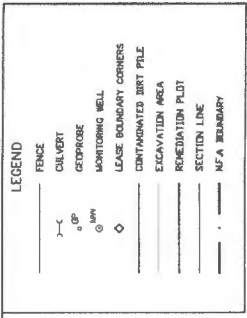

NO FURTHER ACTION (NFA) BOUNDARY

PT #	NORTHING	EASTING
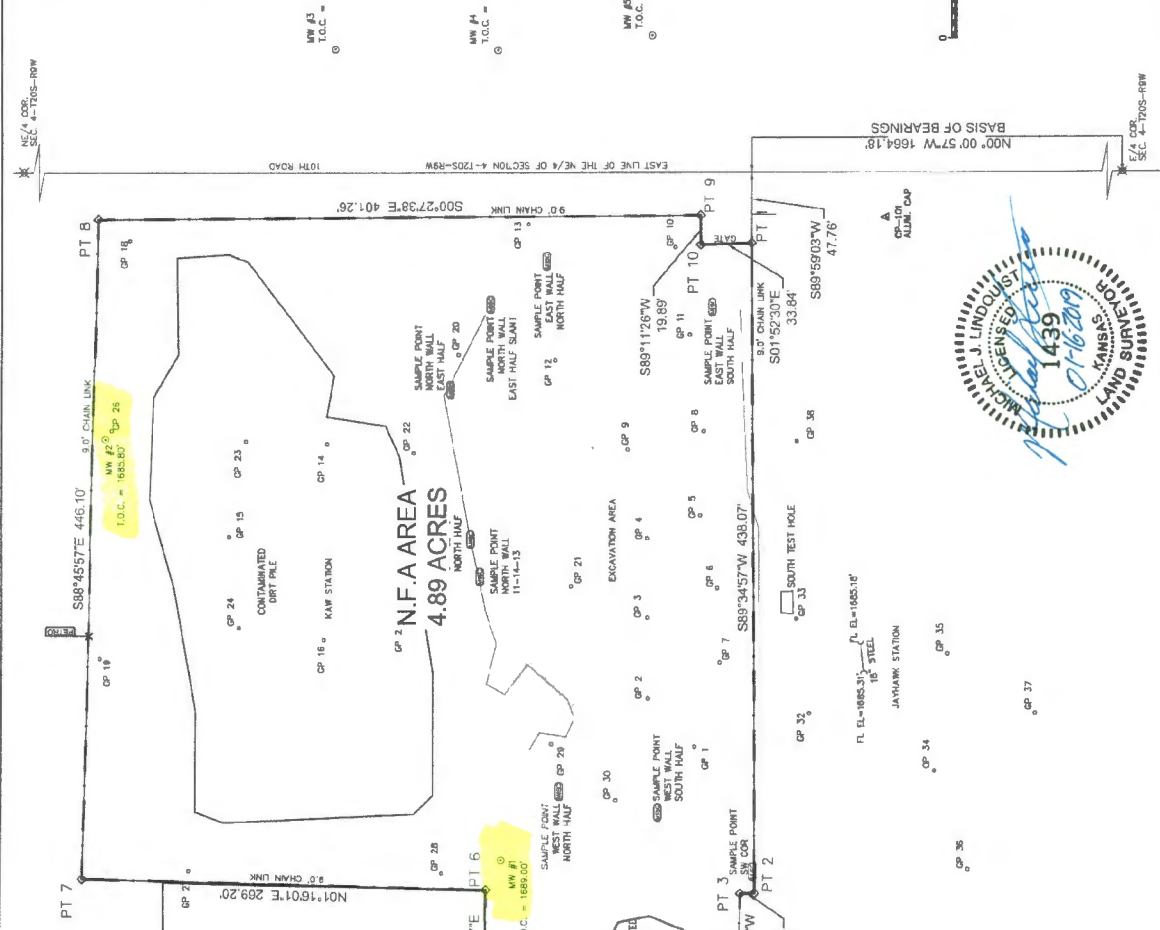


N.F.A. BOUNDARY DESCRIPTION
 A tract of land lying in the Northeast Quarter of Section Four (4), Township Twenty (20) South, Range Nine (9) West of the 6th P.M. Corner of the Southeast of said Quarter; Thence, N 00° 00' 57" W along the East line of said Northeast Quarter a distance of 1,664.19 feet to the Point of Beginning; Thence, S 89° 34' 57" W perpendicular to said line a distance of 47.76 feet to the Point of Beginning; Thence, S 89° 34' 57" W a distance of 438.07 feet; Thence, N 01° 16' 02" W a distance of 9.36 feet; Thence, N 88° 54' 40" W a distance of 60.66 feet; Thence, N 00° 14' 53" W a distance of 167.69 feet; Thence, N 65° 41' 57" E a distance of 83.25 feet; Thence, N 01° 16' 02" E a distance of 289.20 feet; Thence, S 88° 45' 57" E for a distance of 446.10 feet; Thence, S 00° 27' 35" E for a distance of 401.26 feet; Thence, S 89° 11' 26" W for a distance of 19.69 feet; Thence, S 01° 52' 30" E for a distance of 33.84 feet to the Point of Beginning. Containing 4.89 acres more or less.

RECEIVED
JUL 26 2019
BUREAU OF WATER

KAW PIPE LINE COMPANY
 CHASE TERMINAL
 SEC 04, T-20-S, R-9-W
 RICE COUNTY

WILSON & COMPANY
 Engineers & Architects
 Salina, Kansas

DATE: 07/16/2019
 FILE NO: K2420002
 SHEET 1

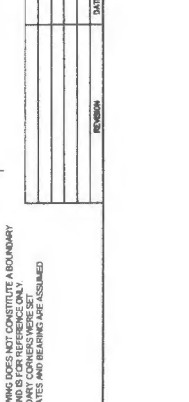

NE/4 COR. SEC. 4-1705-RW
 EAST LINE OF THE NE/4 OF SECTION 4-1705-RW
 10TH ROAD
 500°27'38"E 401.26'
 9.0' CHAIN LINK
 PT B
 8.0' CHAIN LINK
 MW #2
 CP 26
 CP 25
 CP 24
 CONTAMINATED DIRT PILE
 CP 14
 CP 15
 CP 23
 KAW STATION
 CP 18
 CP 19
 CP 20
 SAMPLE POINT NORTH WALL EAST HALF CP 22
