

WATER WELL PLUGGING RECORD Form WWC-5P

KSA 82a-1212

ID NO.

MW-2


1 LOCATION OF WATER WELL: Fraction SE 1/4 NE 1/4 NE 1/4 NE 1/4 Section Number 4 Township Number T 20 S Range Number 9 E W
 County: Rice

Street/Rural Address of Well Location; if unknown, distance & direction from nearest town or intersection: If at owner's address, check here 1/4 mile south of US 56 Highway and 10th Road; Rice County

Global Positioning Systems (GPS) information:
 Latitude: 38.346055 (in decimal degrees)
 Longitude: -98.313062 (in decimal degrees)
 Elevation: _____
 Horizontal Datum: WGS84, NAD83, NAD27
 Collection Method: _____

2 WATER WELL OWNER: CHS
 RR#, St. Address, Box #: 2000 S Main St
 City, State ZIP Code: McPherson, KS 67460

GPS unit (Make/Model: _____)
 Digital Map/Photo, Topographic Map, Land Survey
 Est. Accuracy: < 3 m, 3-5 m, 5-15 m, > 15 m

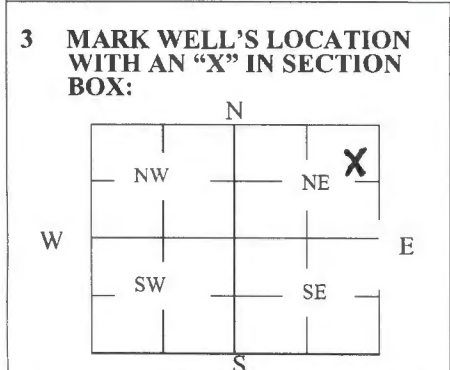

4 DEPTH OF WELL 21 ft.
 WELL'S STATIC WATER LEVEL 4 ft
 WELL WAS USED AS:
 Domestic Public Water Supply Dewatering
 Irrigation Oil Field Water Supply Monitoring
 Feedlot Domestic (Lawn & Garden) Injection Well
 Industrial Air Conditioning Other _____
 Was a chemical/bacteriological sample submitted to Department? Yes No

5 TYPE OF BLANK CASING USED:

Steel RMP (SR) Wrought Fiberglass Other (Specify below)
 PVC ABS Asbestos-Cement Concrete Tile

Blank casing diameter 2 in. Was casing pulled? Yes No If yes, how much all
 Casing height above or below land surface 36 in.

6 GROUT PLUG MATERIAL: Neat cement Cement grout Bentonite Other Top Soil

Grout Plug Intervals: From 0 ft. to 3 ft., From 3 ft. to 21 ft., From — ft. to — ft.

What is the nearest source of possible contamination:
 Septic tank Seepage pit Fuel storage Other (specify below)
 Sewer lines Pit privy Fertilizer storage
 Watertight sewer lines Sewage lagoon Insecticide storage
 Lateral lines Feedyard Abandoned water well Direction from well? _____
 Cess pool Livestock pens Oil well/Gas well How many feet? _____

FROM	TO	PLUGGING MATERIALS	FROM	TO	PLUGGING MATERIALS
0	3	Top Soil			
3	21	Bentonite			

7 CONTRACTOR'S OR LANDOWNER'S CERTIFICATION: This water well was plugged under my jurisdiction and was completed on (mo/day/year) 7/1/2019 and this record is true to the best of my knowledge and belief. Kansas Water Well Contractor's License No. 710. This Water Well Record was completed on (mo/day/year) 7/3/2019 under the business name of Below Ground Surface, Inc. by (signature) Craig R. Hew

Send one white copy to Kansas Department of Health & Environment, Geology Section, 1000 SW Jackson Street, Ste. 420, Topeka, KS 66612-1367. Send one copy to WATER WELL OWNER and retain one for your records.
 Visit us at <http://www.kdheks.gov/waterwell/index.html> Telephone 785-296-5524.
 KSA82a-1212 Revised 1/20/2015

LEGEND

- FENCE
- CULTIVAT
- GEOPROBE
- MONITORING WELL
- LEASE BOUNDARY CORNERS
- CONTAMINATED DIRT PILE
- EXCAVATION AREA
- REMEDIATION PLOT
- SECTION LINE
- N.F.A BOUNDARY

NO OTHER ACTION (N.F.A) BOUNDARY

PT #	NORTHING	EASTING
PT 1	1923518.14	1367032.35
PT 2	1923512.92	1365584.29
PT 3	1923522.30	1365584.09
PT 4	1923523.84	1365313.43
PT 5	1923481.53	1365512.71
PT 6	1923481.07	1365585.95
PT 7	1923381.10	1365601.80
PT 8	1923351.46	1365601.80
PT 9	1923350.24	1366001.13
PT 10	1923249.08	1366001.24



N.F.A BOUNDARY DESCRIPTION
A tract of land, 4.89 acres, in the Northeast Quarter of Section Four (4), Township Twenty (20) South, Range Nine (9) West of the 8th P.M., Commencing at the Southeast corner of said Quarter; Thence, N.00°00'57"W along the East line of said Northeast Quarter, a distance of 1,654.18 feet; Thence, S.89°59'03"W, perpendicular to said line, a distance of 47.76 feet to the Point of Beginning;
From the POINT OF BEGINNING, Thence, S. 89° 34' 57" W a distance of 438.07 feet;
Thence, N.01° 16' 02" W, a distance of 9.36 feet;
Thence, N.88° 54' 40" W, a distance of 80.86 feet;
Thence, N.00° 14' 53" W, a distance of 167.99 feet;
Thence, N.01° 16' 02" E, a distance of 9.36 feet;
Thence, N.01° 16' 02" E, a distance of 9.36 feet;
Thence, S.88° 45' 57" E for a distance of 446.10 feet;
Thence, S.00° 27' 38" E for a distance of 401.26 feet;
Thence, S.01° 52' 30" E for a distance of 33.84 feet to the Point of Beginning.
Containing 4.89 acres, more or less.



THIS DRAWING DOES NOT CONSTITUTE A BOUNDARY SURVEY AND IS FOR REFERENCE ONLY. COORDINATE AND BEARING VALUES ASSUMED.

KAW PIPE LINE COMPANY
CHASE TERMINAL
SEC 04, T-20-S, R-9-W
RICE COUNTY

DATE: 01/16/2019
FILE NO.: K24-0002
SHEET 1

RECEIVED
JUL 26 2019
BUREAU OF WATER