

**WATER WELL PLUGGING RECORD Form WWC-5P**

KSA 82a-1212

ID NO.

MW-5


<b>1 LOCATION OF WATER WELL:</b> County: Rice	Fraction NW ¼ NW¼ SW ¼ NW ¼	Section Number 3	Township Number T 20 S	Range Number 9 <input type="checkbox"/> E <input checked="" type="checkbox"/> W
--	--------------------------------	---------------------	---------------------------	--

Street/Rural Address of Well Location; if unknown, distance & direction from nearest town or intersection: If at owner's address, check here  1/4 mile south of US 56 Highway and 10th Road; Rice County

**Global Positioning Systems (GPS) information:**  
 Latitude: 38.344986 (in decimal degrees)  
 Longitude: -98.31217 (in decimal degrees)  
 Elevation: \_\_\_\_\_  
 Horizontal Datum:  WGS84,  NAD83,  NAD27  
 Collection Method: \_\_\_\_\_

**2 WATER WELL OWNER: CHS**  
 RR#, St. Address, Box #: 2000 S Main St  
 City, State ZIP Code: McPherson, KS 67460

GPS unit (Make/Model): \_\_\_\_\_  
 Digital Map/Photo,  Topographic Map,  Land Survey  
 Est. Accuracy:  < 3 m,  3-5 m,  5-15 m,  > 15 m
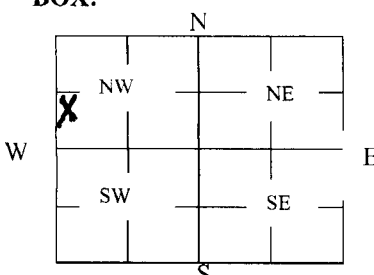
<p><b>3 MARK WELL'S LOCATION WITH AN "X" IN SECTION BOX:</b></p> 	<p><b>4 DEPTH OF WELL</b> <u>23</u> ft.</p> <p>WELL'S STATIC WATER LEVEL _____ ft</p> <p>WELL WAS USED AS:</p> <table style="width:100%;"> <tr> <td><input type="checkbox"/> Domestic</td> <td><input type="checkbox"/> Public Water Supply</td> <td><input type="checkbox"/> Dewatering</td> </tr> <tr> <td><input type="checkbox"/> Irrigation</td> <td><input type="checkbox"/> Oil Field Water Supply</td> <td><input checked="" type="checkbox"/> Monitoring</td> </tr> <tr> <td><input type="checkbox"/> Feedlot</td> <td><input type="checkbox"/> Domestic (Lawn &amp; Garden)</td> <td><input type="checkbox"/> Injection Well</td> </tr> <tr> <td><input type="checkbox"/> Industrial</td> <td><input type="checkbox"/> Air Conditioning</td> <td><input type="checkbox"/> Other _____</td> </tr> </table> <p>Was a chemical/bacteriological sample submitted to Department? Yes <input type="checkbox"/> No <input checked="" type="checkbox"/></p>	<input type="checkbox"/> Domestic	<input type="checkbox"/> Public Water Supply	<input type="checkbox"/> Dewatering	<input type="checkbox"/> Irrigation	<input type="checkbox"/> Oil Field Water Supply	<input checked="" type="checkbox"/> Monitoring	<input 

**5 TYPE OF BLANK CASING USED:**

Steel  RMP (SR)  Wrought  Fiberglass  Other (Specify below)  
 PVC  ABS  Asbestos-Cement  Concrete Tile

Blank casing diameter 2 in. Was casing pulled? Yes  No  If yes, how much 5 feet  
 Casing height above or below land surface 36 in.

**6 GROUT PLUG MATERIAL:**  Neat cement  Cement grout  Bentonite  Other Top Soil

Grout Plug Intervals: From 0 ft. to 3 ft., From 3 ft. to 23 ft., From \_\_\_\_\_ ft. to \_\_\_\_\_ ft.


What is the nearest source of possible contamination:

<input type="checkbox"/> Septic tank	<input type="checkbox"/> Seepage pit	<input type="checkbox"/> Fuel storage	<input type="checkbox"/> Other (specify below)
<input type="checkbox"/> Sewer lines	<input type="checkbox"/> Pit privy	<input type="checkbox"/> Fertilizer storage	_____
<input type="checkbox"/> Watertight sewer lines	<input type="checkbox"/> Sewage lagoon	<input type="checkbox"/> Insecticide storage	_____
<input type="checkbox"/> Lateral lines	<input type="checkbox"/> Feedyard	<input type="checkbox"/> Abandoned water well	Direction from well? _____
<input type="checkbox"/> Cess pool	<input type="checkbox"/> Livestock pens	<input type="checkbox"/> Oil well/Gas well	How many feet? _____

FROM	TO	PLUGGING MATERIALS	FROM	TO	PLUGGING MATERIALS
0	3	Top Soil			
3	23	Bentonite			

**7 CONTRACTOR'S OR LANDOWNER'S CERTIFICATION:** This water well was plugged under my jurisdiction and was completed on (mo/day/year) 10/28/2019 and this record is true to the best of my knowledge and belief. Kansas Water Well Contractor's License No. 710. This Water Well Record was completed on (mo/day/year) 11/4/2019 under the business name of Below Ground Surface, Inc. by (signature) Graig R. Hewitt

Send one white copy to Kansas Department of Health & Environment, Geology Section, 1000 SW Jackson Street, Ste. 420, Topeka, KS 66612-1367. Send one copy to WATER WELL OWNER and retain one for your records.  
 Visit us at <http://www.kdheks.gov/waterwell/index.html> Telephone 785-296-5524.

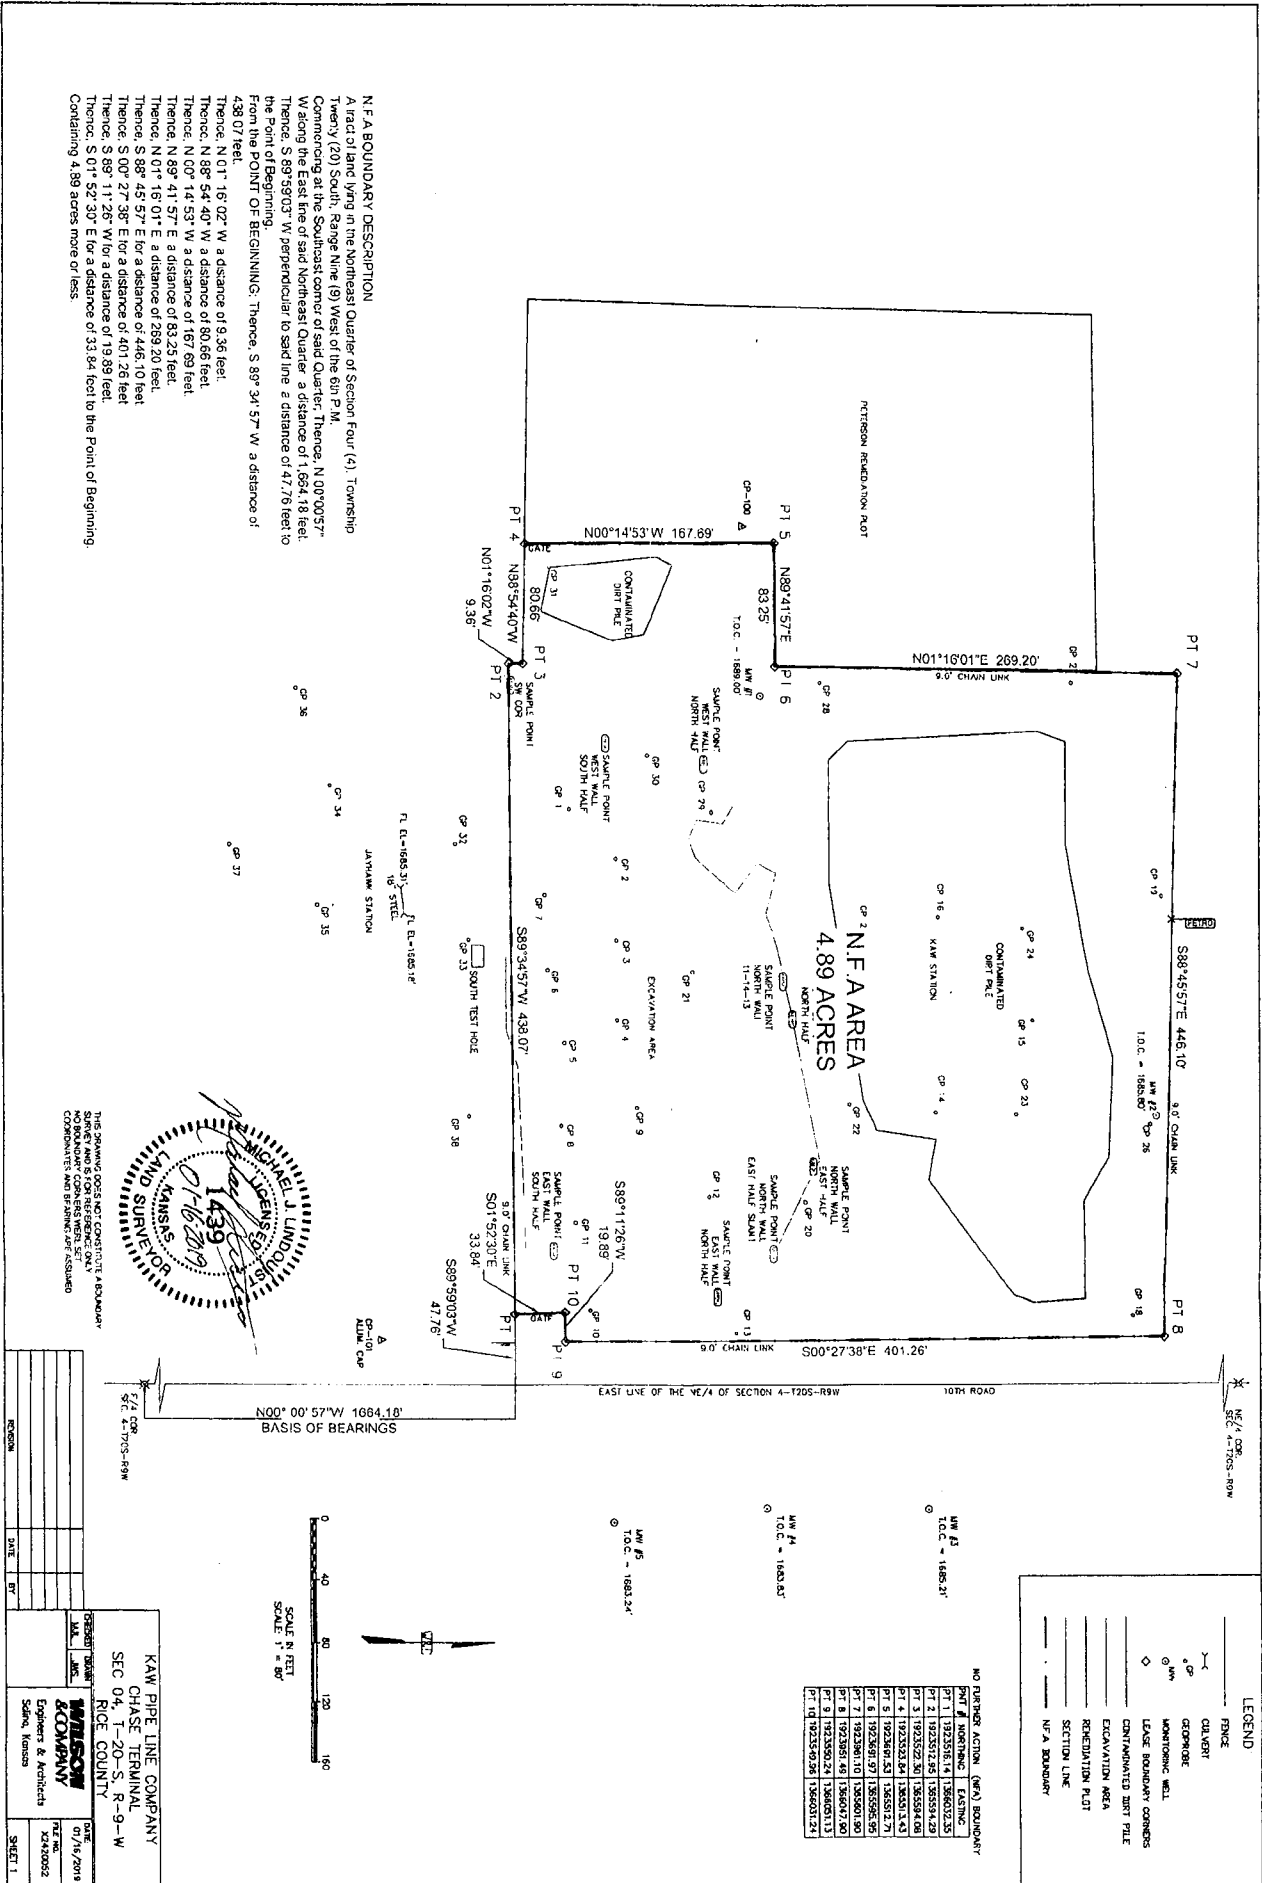

**N.F.A. BOUNDARY DESCRIPTION**



Thence, N. 01° 16' 02" W. a distance of 9.36 feet;

Thence, N. 88° 54' 40" W. a distance of 80.66 feet;

Thence, N. 00° 14' 53" W. a distance of 167.69 feet;

Thence, N. 89° 41' 57" E. a distance of 83.25 feet;


Thence, S. 88° 45' 57" E. for a distance of 446.10 feet;

Thence, S. 00° 27' 38" E. for a distance of 401.26 feet;

Thence, S. 89° 11' 26" W. for a distance of 19.89 feet;

Thence, S. 01° 52' 30" E. for a distance of 33.84 feet to the Point of Beginning.

Containing 4.89 acres more or less.




NO.	DATE	BY

**KAW PIPE LINE COMPANY**  
CHASE TERMINAL  
SEC 04, T-20-S, R-9-W  
RICE COUNTY

**WILSON COMPANY**  
Engineers & Architects  
Salina, Kansas

FILE NO: K242005Z  
SHEET 1