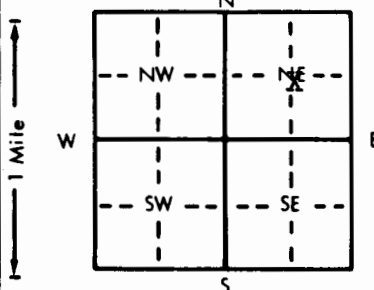


1 LOCATION OF WATER WELL: County: Rice Fraction: C  $\frac{1}{4}$  NE  $\frac{1}{4}$  NE  $\frac{1}{4}$  Section Number: 4 Township Number: T 20 S Range Number: R 9W E/W

Distance and direction from nearest town or city street address of well if located within city?  
1 1/2 E of Chase, Kansas

2 WATER WELL OWNER: Steve Peterson Lobo Drilling Company Peterson No. 1  
 RR#, St. Address, Box #: Route 1 Box 877 Board of Agriculture, Division of Water Resources  
 City, State, ZIP Code: Chase, Ks. 67524 Great Bend, Kansas 67530 Application Number: Unknown

3 LOCATE WELL'S LOCATION WITH AN "X" IN SECTION BOX:  


4 DEPTH OF COMPLETED WELL: 138 ft. ELEVATION: Unknown  
 Depth(s) Groundwater Encountered: 1.17 ft. 2. .... ft. 3. .... ft.  
 WELL'S STATIC WATER LEVEL: 17 ft. below land surface measured on mo/day/yr 8/28/85  
 Pump test data: Well water was .... ft. after .... hours pumping .... gpm  
 Est. Yield: 60 gpm: Well water was .... ft. after .... hours pumping .... gpm  
 Bore Hole Diameter: 8 in. to 138 ft., and .... in. to .... ft.  
 WELL WATER TO BE USED AS:  
 1 Domestic 3 Feedlot 6 Oil field water supply 9 Dewatering 12 Other (Specify below)  
 2 Irrigation 4 Industrial 7 Lawn and garden only 10 Observation well  
 Was a chemical/bacteriological sample submitted to Department? Yes.....No.....; If yes, mo/day/yr sample was submitted  
 Water Well Disinfected? Yes No

5 TYPE OF BLANK CASING USED:  
 1 Steel 3 RMP (SR) 5 Wrought iron 8 Concrete tile CASING JOINTS: Glued ..... Clamped .....  
 2 PVC 4 ABS 6 Asbestos-Cement 9 Other (specify below) Welded .....  
 7 Fiberglass ..... Threaded .....  
 Blank casing diameter: 5 in. to 118 ft., Dia. .... in. to .... ft., Dia. .... in. to .... ft.  
 Casing height above land surface: 12 in., weight 2.8 lbs./ft. Wall thickness or gauge No. Sch. 40  
 TYPE OF SCREEN OR PERFORATION MATERIAL:  
 1 Steel 3 Stainless steel 5 Fiberglass 7 PVC 10 Asbestos-cement  
 2 Brass 4 Galvanized steel 6 Concrete tile 8 RMP (SR) 11 Other (specify) .....  
 9 ABS 12 None used (open hole)  
 SCREEN OR PERFORATION OPENINGS ARE:  
 1 Continuous slot 3 Mill slot 5 Gauzed wrapped 8 Saw cut 11 None (open hole)  
 2 Louvered shutter 4 Key punched 6 Wire wrapped 9 Drilled holes  
 7 Torch cut 10 Other (specify) .....  
 SCREEN-PERFORATED INTERVALS: From 118 ft. to 138 ft., From ..... ft. to ..... ft.  
 From ..... ft. to ..... ft., From ..... ft. to ..... ft.  
 GRAVEL PACK INTERVALS: From 10 ft. to 138 ft., From ..... ft. to ..... ft.  
 From ..... ft. to ..... ft., From ..... ft. to ..... ft.

6 GROUT MATERIAL: 1 Neat cement 2 Cement grout 3 Bentonite 4 Other .....  
 Grout Intervals: From 0 ft. to 10 ft., From ..... ft. to ..... ft., From ..... ft. to ..... ft.  
 What is the nearest source of possible contamination:  
 1 Septic tank 4 Lateral lines 7 Pit privy 10 Livestock pens 14 Abandoned water well  
 2 Sewer lines 5 Cess pool 8 Sewage lagoon 11 Fuel storage 15 Oil well/Gas well  
 3 Watertight sewer lines 6 Seepage pit 9 Feedyard 12 Fertilizer storage 16 Other (specify below)  
 13 Insecticide storage .....  
 Direction from well? South How many feet? 60

| FROM | TO  | LITHOLOGIC LOG | FROM | TO | LITHOLOGIC LOG |
|------|-----|----------------|------|----|----------------|
| 0    | 15  | Clay           |      |    |                |
| 15   | 120 | Sandy Clay     |      |    |                |
| 120  | 138 | Fine Sand      |      |    |                |
|      |     |                |      |    |                |
|      |     |                |      |    |                |
7 CONTRACTOR'S OR LANDOWNER'S CERTIFICATION: This water well was (1) constructed, (2) reconstructed, or (3) plugged under my jurisdiction and was completed on (mo/day/year) 8/28/85 and this record is true to the best of my knowledge and belief. Kansas Water Well Contractor's License No. 186. This Water Well Record was completed on (mo/day/yr) 9/21/85 under the business name of Kelly's Water Well Service by (signature) [Signature]

INSTRUCTIONS: Use typewriter or ball point pen, PLEASE PRESS FIRMLY and PRINT clearly. Please fill in blanks, underline or circle the correct answers. Send top three copies to Kansas Department of Health and Environment, Division of Environment, Environmental Geology Section, Topeka, KS 66620. Send one to WATER WELL OWNER and retain one for your records.