

WIELAND #2

1 LOCATION OF WATER WELL	Fraction	Section Number	Township Number	Range Number
County: <u>RICE</u>	<u>SE 1/4 SW 1/4 NE 1/4</u>	<u>5</u>	<u>T 20 S</u>	<u>R 9 EW</u>

Distance and direction from nearest town or city? CHASE 1/4 S E 1/2 S WESTSIDE  
 Street address of well if located within city?


2 WATER WELL OWNER: EMPHASIS OIL OPERATIONS  
 RR#, St. Address, Box #: 506  
 City, State, ZIP Code: RUSSELL KS. 67665  
 Board of Agriculture, Division of Water Resources  
 Application Number: 781-373

3 DEPTH OF COMPLETED WELL: 57 ft. Bore Hole Diameter: 6 3/4 in. to 57 ft., and \_\_\_\_\_ in. to \_\_\_\_\_ ft.  
 Well Water to be used as:  
 1 Domestic 3 Feedlot 5 Public water supply 8 Air conditioning 11 Injection well  
 2 Irrigation 4 Industrial 6 Oil field water supply 9 Dewatering 12 Other (Specify below)  
 7 Lawn and garden only 10 Observation well  
 Well's static water level: 8 ft. below land surface measured on MAY month 30 day 1981 year  
 Pump Test Data NONE: Well water was \_\_\_\_\_ ft. after \_\_\_\_\_ hours pumping \_\_\_\_\_ gpm  
 Est. Yield \_\_\_\_\_ gpm: Well water was \_\_\_\_\_ ft. after \_\_\_\_\_ hours pumping \_\_\_\_\_ gpm

4 TYPE OF BLANK CASING USED:  
 1 Steel 3 RMP (SR) 5 Wrought iron 8 Concrete tile Casing Joints: Glued X Clamped  
 2 PVC 4 ABS 6 Asbestos-Cement 9 Other (specify below) Welded \_\_\_\_\_  
 7 Fiberglass \_\_\_\_\_ Threaded \_\_\_\_\_  
 Blank casing dia: 4 1/2 in. to 37 ft., Dia \_\_\_\_\_ in. to \_\_\_\_\_ ft., Dia \_\_\_\_\_ in. to \_\_\_\_\_ ft.  
 Casing height above land surface: 12 in., weight 1.832 lbs./ft. Wall thickness or gauge No: 1190  
 TYPE OF SCREEN OR PERFORATION MATERIAL:  
 1 Steel 3 Stainless steel 5 Fiberglass 8 RMP (SR) 10 Asbestos-cement 11 Other (specify) \_\_\_\_\_  
 2 Brass 4 Galvanized steel 6 Concrete tile 9 ABS 12 None used (open hole)  
 Screen or Perforation Openings Are: 1/8  
 1 Continuous slot 3 Mill slot 5 Gauzed wrapped 8 Saw cut 11 None (open hole)  
 2 Louvered shutter 4 Key punched 6 Wire wrapped 9 Drilled holes  
 7 Torch cut 10 Other (specify) \_\_\_\_\_  
 Screen-Perforation Dia: 4 1/2 in. to 57 ft., Dia \_\_\_\_\_ in. to \_\_\_\_\_ ft., Dia \_\_\_\_\_ in. to \_\_\_\_\_ ft.  
 Screen-Perforated Intervals: From 37 ft. to 57 ft., From \_\_\_\_\_ ft. to \_\_\_\_\_ ft., From \_\_\_\_\_ ft. to \_\_\_\_\_ ft.  
 Gravel Pack Intervals: From 27 ft. to 57 ft., From \_\_\_\_\_ ft. to \_\_\_\_\_ ft., From \_\_\_\_\_ ft. to \_\_\_\_\_ ft.

5 GROUT MATERIAL: 1 Neat cement 2 Cement grout 3 Bentonite 4 Other \_\_\_\_\_  
 Grouted Intervals: From 0 ft. to 10 ft., From \_\_\_\_\_ ft. to \_\_\_\_\_ ft., From \_\_\_\_\_ ft. to \_\_\_\_\_ ft.  
 What is the nearest source of possible contamination: NONE  
 1 Septic tank 4 Cess pool 7 Sewage lagoon 10 Fuel storage 14 Abandoned water well  
 2 Sewer lines 5 Seepage pit 8 Feed yard 11 Fertilizer storage 15 Oil well/Gas well  
 3 Lateral lines 6 Pit privy 9 Livestock pens 12 Insecticide storage 16 Other (specify below) \_\_\_\_\_  
 13 Watertight sewer lines \_\_\_\_\_  
 Direction from well \_\_\_\_\_ How many feet \_\_\_\_\_? Water Well Disinfected? Yes \_\_\_\_\_ No   
 Was a chemical/bacteriological sample submitted to Department? Yes \_\_\_\_\_ No \_\_\_\_\_  
 If Yes: Pump Manufacturer's name \_\_\_\_\_ Model No. \_\_\_\_\_ HP \_\_\_\_\_ Volts \_\_\_\_\_  
 Depth of Pump Intake \_\_\_\_\_ ft. Pumps Capacity rated at \_\_\_\_\_ gal./min.  
 Type of pump: 1 Submersible 2 Turbine 3 Jet 4 Centrifugal 5 Reciprocating 6 Other \_\_\_\_\_

6 CONTRACTOR'S OR LANDOWNER'S CERTIFICATION: This water well was (1) constructed, (2) reconstructed, or (3) plugged under my jurisdiction and was completed on MAY month 30 day 1981 year and this record is true to the best of my knowledge and belief. Kansas Water Well Contractor's License No. 389  
 This Water Well Record was completed on JUNE month 5 day 1981 year under the business name of REISER WATER WELL SERVICE INC. by (signature) Budagh Reiser

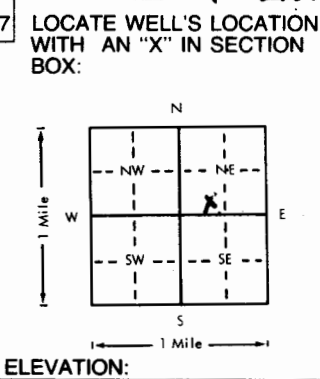

FROM	TO	LITHOLOGIC LOG	FROM	TO	LITHOLOGIC LOG
<u>0</u>	<u>7</u>	<u>SOIL</u>			
<u>7</u>	<u>15</u>	<u>CLAY</u>			

ELEVATION:  
 Depth(s) Groundwater Encountered 1. \_\_\_\_\_ ft. 2. \_\_\_\_\_ ft. 3. \_\_\_\_\_ ft. 4. \_\_\_\_\_ ft. (Use a second sheet if needed)

INSTRUCTIONS: Use typewriter or ball point pen, please press firmly and PRINT clearly. Please fill in blanks, underline or circle the correct answers. Send top three copies to Kansas Department of Health and Environment, Division of Environment, Water Well Contractors, Topeka, KS 66620. Send one to WATER WELL OWNER and retain one for your records.

OFFICE USE ONLY  
T  
20  
R  
9  
EW  
SEC.  
5  
SE 1/4 SW 1/4 NE 1/4

X