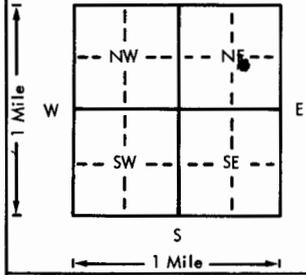


USE TYPEWRITER OR BALL POINT PEN-PRESS FIRMLY, PRINT CLEARLY.

WATER WELL RECORD
KSA 82a-1201-1215

Kansas Department of Health and Environment-Division of Environment
(Water well Contractors)
Topeka, Kansas 66620

1. Location of well:	County Rice	Fraction NW 1/4 NW 1/4 NE 1/4	Section number 24	Township number T 30 S R 9 E/W	Range number
2. Distance and direction from nearest town or city: Street address of well location if in city: 2.5 3 W Lyons			3. Owner of well: Kenneth Knight R.R. or street: RR 1 City, state, zip code: Lyons, Kans.		
4. Locate with "X" in section below: N W E S 1 Mile			Sketch map: 		
5. Type and color of material			From	To	6. Bore hole dia. 28 in. Completion date 8/7/75 Well depth 58 ft.
Top soil			0	2	7. Cable tool <input type="checkbox"/> Rotary <input type="checkbox"/> Driven <input type="checkbox"/> Dug <input type="checkbox"/> <input type="checkbox"/> Hollow rod <input type="checkbox"/> Jetted <input type="checkbox"/> Bored <input checked="" type="checkbox"/> Reverse rotary
Yellow/brown clay			2	4 1/2	8. Use: Domestic <input type="checkbox"/> Public supply <input type="checkbox"/> Industry <input type="checkbox"/> <input checked="" type="checkbox"/> Irrigation <input type="checkbox"/> Air conditioning <input type="checkbox"/> Stock <input type="checkbox"/> <input type="checkbox"/> Lawn <input type="checkbox"/> Oil field water <input type="checkbox"/> Other
Sand and gravel			4 1/2	12	9. Casing: Material Transil Height: Above or below Threaded <input type="checkbox"/> Welded <input type="checkbox"/> Surface 12 in. RMP <input type="checkbox"/> PVC <input type="checkbox"/> Weight 30 lbs./ft. Dia. 1 1/2 in. to 3 1/2 ft. depth Wall Thickness: inches or Dia. <input type="checkbox"/> in. to <input type="checkbox"/> ft. depth gage No. 34
Brown clay			12	14	10. Screen: Manufacturer's name Johnson Type Sanded Dia. 1 1/2 Slot/gauze 3/16 Length 2 1/2 Set between 32 ft. and 58 ft. ft. and <input type="checkbox"/> ft.
Gravel (clean, coarse, loose)			14	33	Gravel pack? yes Size range of material 1/8 - 1/2
Brown/gray clay			33	37	11. Static water level: <input type="checkbox"/> mo./day/yr. 8 ft. below land surface Date 7/11/75
Sand and gravel (clean, loose)			37	55	12. Pumping level below land surfaces: 42 ft. after 1 hrs. pumping 1000 g.p.m. 80 ft. after 1 1/2 hrs. pumping 600 g.p.m. Estimated maximum yield <input type="checkbox"/> g.p.m.
Clay			55	77	13. Water sample submitted: <input type="checkbox"/> mo./day/yr. <input checked="" type="checkbox"/> Yes <input checked="" type="checkbox"/> No Date XXXXXX
Fine sand			77	80	14. Well head completion: <input type="checkbox"/> Pitless adapter <input type="checkbox"/> Inches above grade
Brown and white clay			80	140	<input checked="" type="checkbox"/> Well grouted? yes With: <input type="checkbox"/> Neat cement <input checked="" type="checkbox"/> Bentonite <input type="checkbox"/> Concrete Depth: From <input type="checkbox"/> ft. to <input type="checkbox"/> ft.
Sandy brown clay			140	150	15. Nearest source of possible contamination: ft. <input type="checkbox"/> Direction <input type="checkbox"/> Type <input type="checkbox"/> Well disinfected upon completion? <input type="checkbox"/> Yes <input checked="" type="checkbox"/> No
Sandy clay			150	160	17. Pump: <input type="checkbox"/> Not installed Manufacturer's name Fairbanks-Morse Model number F-12 1A HP 6.6 Volts 440 Length of drop pipe 40 ft. capacity 1000 g.p.m. Type: <input type="checkbox"/> Submersible <input checked="" type="checkbox"/> Turbine <input type="checkbox"/> Jet <input type="checkbox"/> Reciprocating <input type="checkbox"/> Centrifugal <input type="checkbox"/> Other
(Use a second sheet if needed)					
18. Elevation:	19. Remarks:			20. Water well contractor's certification: This well was drilled under my jurisdiction and this report is true to the best of my knowledge and belief. Darling Drilling Co. 189 Business name License No. Address 1211 W. 4th Hutchinson Ks. Signed Darling Drilling Co. Date 8-7-75 Authorized Representative	
Topography: <input type="checkbox"/> Hill <input type="checkbox"/> Slope <input checked="" type="checkbox"/> Upland <input type="checkbox"/> Valley					