


1 LOCATION OF WATER WELL: Rice County: Fraction NE 1/4 ENE 1/4 NE 1/4 Section Number 34 Township Number T 20 S Range Number R 9W E/W

Distance and direction from nearest town or city street address of well if located within city? 5 S, 2 3/4 E of Chase, Kansas

2 WATER WELL OWNER: Allen Drilling Company RR#, St. Address, Box #: 1926 Main City, State, ZIP Code: Great Bend, Kansas 67530 Board of Agriculture, Division of Water Resources Application Number: Unknown

3 LOCATE WELL'S LOCATION WITH AN "X" IN SECTION BOX: 4 DEPTH OF COMPLETED WELL: 60 ft. ELEVATION: Unknown

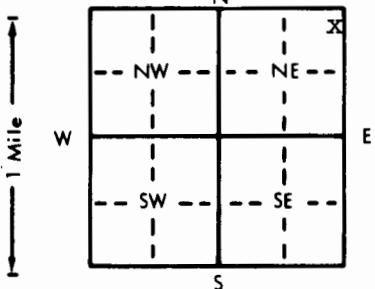

Depth(s) Groundwater Encountered 1. 20 ft. 2. ft. 3. ft. WELL'S STATIC WATER LEVEL 20 ft. below land surface measured on mo/day/yr 7/17/81 Pump test data: Well water was ft. after hours pumping gpm Est. Yield 60 gpm: Well water was ft. after hours pumping gpm Bore Hole Diameter 8 in. to 60 ft., and in. to ft. WELL WATER TO BE USED AS: 5 Public water supply 8 Air conditioning 11 Injection well 1 Domestic 3 Feedlot 6 Oil field water supply 9 Dewatering 12 Other (Specify below) 2 Irrigation 4 Industrial 7 Lawn and garden only 10 Observation well Was a chemical/bacteriological sample submitted to Department? Yes No; If yes, mo/day/yr sample was submitted Water Well Disinfected? Yes No

5 TYPE OF BLANK CASING USED: 1 Steel 3 RMP (SR) 5 Wrought iron 8 Concrete tile CASING JOINTS: Glued Clamped 2 PVC 4 ABS 6 Asbestos-Cement 9 Other (specify below) Welded 7 Fiberglass Threaded

Blank casing diameter 5 in. to 40 ft., Dia 12 in., weight 2.8 lbs./ft. Wall thickness or gauge No. Sh. 40

TYPE OF SCREEN OR PERFORATION MATERIAL: 1 Steel 3 Stainless steel 5 Fiberglass 7 PVC 10 Asbestos-cement 2 Brass 4 Galvanized steel 6 Concrete tile 8 RMP (SR) 11 Other (specify) 9 ABS 12 None used (open hole)

SCREEN OR PERFORATION OPENINGS ARE: 1 Continuous slot 3 Mill slot 5 Gauzed wrapped 8 Saw cut 11 None (open hole) 2 Louvered shutter 4 Key punched 6 Wire wrapped 9 Drilled holes 7 Torch cut 10 Other (specify)

SCREEN-PERFORATED INTERVALS: From 40 ft. to 60 ft., From ft. to ft. GRAVEL PACK INTERVALS: From 10 ft. to 60 ft., From ft. to ft.

6 GROUT MATERIAL: 1 Neat cement 2 Cement grout 3 Bentonite 4 Other Grout Intervals: From 0 ft. to 10 ft., From ft. to ft., From ft. to ft.

What is the nearest source of possible contamination: 1 Septic tank 4 Lateral lines 7 Pit privy 10 Livestock pens 14 Abandoned water well 2 Sewer lines 5 Cess pool 8 Sewage lagoon 11 Fuel storage 15 Oil well/Gas well 3 Watertight sewer lines 6 Seepage pit 9 Feedyard 12 Fertilizer storage 16 Other (specify below) 13 Insecticide storage 60 Direction from well? South 0 How many feet?

Table with columns FROM, TO, LITHOLOGIC LOG, FROM, TO, LITHOLOGIC LOG. Row 1: 0, 10, Clay. Row 2: 10, 60, Sand and Gravel.

7 CONTRACTOR'S OR LANDOWNER'S CERTIFICATION: This water well was (1) constructed, (2) reconstructed, or (3) plugged under my jurisdiction and was completed on (mo/day/year) 7/17/81 and this record is true to the best of my knowledge and belief, Kansas Water Well Contractor's License No. 186 This Water Well Record was completed on (mo/day/yr) 8/25/81 under the business name of Kellys Water Wells by (signature) George Wood

INSTRUCTIONS: Use typewriter or ball point pen, PLEASE PRESS FIRMLY and PRINT clearly. Please fill in blanks, underline or circle the correct answers. Send top three copies to Kansas Department of Health and Environment, Division of Environment, Environmental Geology Section, Topeka, KS 66620. Send one to WATER WELL OWNER and retain one for your records.