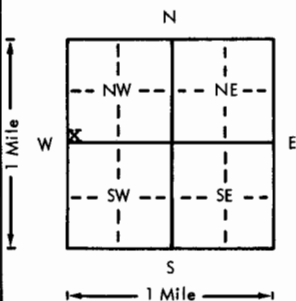


USE TYPEWRITER OR BALL
POINT PEN-PRESS FIRMLY,
PRINT CLEARLY.

WATER WELL RECORD
KSA 82a-1201-1215

Kansas Department of Health and
Environment-Division of Environment
(Water well Contractors)
Topeka, Kansas 66620

1. Location of well:	County Rice	Fraction SW 1/4 SW 1/4 NW 1/4	Section number 34	Township number T 20 S R 9	Range number 9
2. Distance and direction from nearest town or city: 2 miles North of Alden, KS Street address of well location if in city:			3. Owner of well: Mrs. Rodney Harrison R.R. or street: Route 2 City, state, zip code: Sterling, KS 67579		
4. Locate with "X" in section below: Sketch map: 			6. Bore hole dia. <u>24</u> in. Completion date 10-12-76 Well depth <u>65</u> ft.		
5. Type and color of material			7. <input type="checkbox"/> Cable tool <input type="checkbox"/> Rotary <input type="checkbox"/> Driven <input type="checkbox"/> Dug <input type="checkbox"/> Hollow rod <input type="checkbox"/> Jetted <input type="checkbox"/> Bored <input checked="" type="checkbox"/> Reverse rotary		
			8. Use: <input type="checkbox"/> Domestic <input type="checkbox"/> Public supply <input type="checkbox"/> Industry <input checked="" type="checkbox"/> Irrigation <input type="checkbox"/> Air conditioning <input type="checkbox"/> Stock <input type="checkbox"/> Lawn <input type="checkbox"/> Oil field water <input type="checkbox"/> Other		
			9. Casing: Material <u>Steel</u> Height: <u>Above</u> or below Threaded <input type="checkbox"/> Welded <input checked="" type="checkbox"/> Surface <u>12</u> in. RMP <input type="checkbox"/> PVC <input type="checkbox"/> Weight <u>30.3</u> lbs./ft. Dia. <u>16</u> in. to <u>35</u> ft. depth Wall thickness: inches or Dia. <input type="checkbox"/> in. to <input type="checkbox"/> ft. depth Gauge No. <u>7 ga.</u>		
			10. Screen: Manufacturer's name <u>Doerr</u> Type <u>Double-slot</u> Dia. <u>16"</u> <u>Slot</u> gauze <u>1/8"</u> Length <u>30'</u> Set between <u>35</u> ft. and <u>65</u> ft. Gravel pack? <u>yes</u> Size range of material <u>3/8"-200</u>		
			11. Static water level: <u>20</u> ft. below land surface Date <u>8-20-76</u> mo./day/yr.		
			12. Pumping level below land surfaces: <u>N/C</u> <u> </u> ft. after <u> </u> hrs. pumping <u> </u> g.p.m. <u> </u> ft. after <u> </u> hrs. pumping <u> </u> g.p.m. Estimated maximum yield <u> </u> g.p.m.		
			13. Water sample submitted: <u> </u> mo./day/yr. Yes <input checked="" type="checkbox"/> No <input type="checkbox"/> Date <u> </u>		
			14. Well head completion: <input type="checkbox"/> Pitless adapter <u>12</u> Inches above grade		
			15. Well grouted? <u>yes</u> With: <input checked="" type="checkbox"/> Neat cement <input type="checkbox"/> Bentonite <input type="checkbox"/> Concrete Depth: From <u>0</u> ft. to <u>10</u> ft.		
			16. Nearest source of possible contamination: ft. <u> </u> Direction <u> </u> Type <u> </u> Well disinfected upon completion? <u> </u> Yes <input checked="" type="checkbox"/> No <input type="checkbox"/>		
			17. Pump: <u>Not installed</u> Manufacturer's name <u>Peerless</u> Pump Model number <u>12MB-2</u> HP <u>20</u> Volts <u>460</u> Length of drop pipe <u>60</u> ft. capacity <u>900</u> g.p.m. Type: <input type="checkbox"/> Submersible <input checked="" type="checkbox"/> Turbine <input type="checkbox"/> Jet <input type="checkbox"/> Reciprocating <input type="checkbox"/> Centrifugal <input type="checkbox"/> Other		
			(Use a second sheet if needed)		
18. Elevation:		19. Remarks:		20. Water well contractor's certification: This well was drilled under my jurisdiction and this report is true to the best of my knowledge and belief. Clarke Well & Eq. Inc. License No. <u>185</u> Business name <u>Great Bend, KS</u> Address <u>67530</u> Signed <u> </u> Date <u>10-14-76</u> Authorized representative	
Topography: <input type="checkbox"/> Hill <input type="checkbox"/> Slope <input type="checkbox"/> Upland <input type="checkbox"/> Valley					

20
 1
 9
 34
 SW 1/4 NW 1/4
 Sec 34
 1/4 1/4 1/4