


1 LOCATION OF WATER WELL:	Fraction	Section Number	Township Number	Range Number
County: McPherson	SE ¼ SE ¼ SW ¼	15	T 21 S	R 1

Distance and direction from nearest town or city street address of well if located within city?
4 miles East & 1 mile North of Moundridge, KS

2	WATER WELL OWNER:	Edward Delay	
	RR#, St. Address, Box # :	Rt 2	Board of Agriculture, Division of Water Resources
	City, State, ZIP Code :	Moundridge, KS 67107	Application Number:

3 LOCATE WELL'S LOCATION WITH AN "X" IN SECTION BOX: 4 DEPTH OF COMPLETED WELL: 54 ft. ELEVATION:
 Depth(s) Groundwater Encountered 1 12 ft 2 ft 3 ft

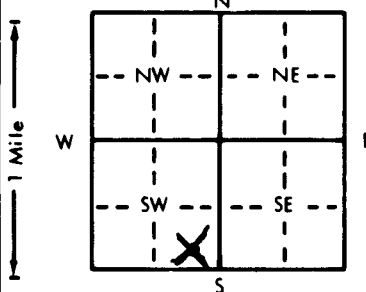

4 DEPTH OF COMPLETED WELL . 54 ft. ELEVATION:
 Depth(s) Groundwater Encountered 1. . 12 ft. 2. ft. 3. ft.
 WELL'S STATIC WATER LEVEL . 12 ft. below land surface measured on mo/day/yr . . 2-4-92
 Pump test data: Well water was ft. after hours pumping gpm
 Est. Yield . 7-8 . . gpm: Well water was . . 48 ft. after . . . 1 hours pumping . . 8 gpm
 Bore Hole Diameter . 8 in. to . . . 56 ft., and in. to ft.
 WELL WATER TO BE USED AS: 5 Public water supply 8 Air conditioning 11 Injection well
 1 Domestic 3 Feedlot 6 Oil field water supply 9 Dewatering 12 Other (Specify below)
 2 Irrigation 4 Industrial 7 Lawn and garden only 10 Monitoring well
 Was a chemical/bacteriological sample submitted to Department? Yes No . . ☒; If yes, mo/day/yr sample was sub-
 mitted Water Well Disinfected? Yes ☒ No

5	TYPE OF BLANK CASING USED:		5 Wrought iron	8 Concrete tile	CASING JOINTS: Glued ☒ Clamped Welded Threaded
	1 Steel	3 RMP (SR)	6 Asbestos-Cement	9 Other (specify below)	
	2 PVC	4 ABS	7 Fiberglass		

Blank casing diameter 5 in. to . . . 44 ft., Dia in. to ft., Dia in. to ft.
Casing height above land surface 1.2 in., weight 2.37 lbs./ft. Wall thickness or gauge No. . . . 2.14

TYPE OF SCREEN OR PERFORATION MATERIAL:			7 PVC	10 Asbestos-cement
1 Steel	3 Stainless steel	5 Fiberglass	8 RMP (SR)	11 Other (specify)
2 Brass	4 Galvanized steel	6 Concrete tile	9 ABS	12 None used (open hole)

SCREEN OR PERFORATION OPENINGS ARE:		5 Gauzed wrapped	8 Saw cut	11 None (open hole)
1 Continuous slot	3 Mill slot	6 Wire wrapped	9 Drilled holes	
2 Louvered shutter	4 Key punched	7 Torch cut	10 Other (specify)	

SCREEN-PERFORATED INTERVALS:	From . . . 44	ft. to . . . 54	ft., From	ft. to	ft.
	From	ft. to	ft., From	ft. to	ft.
GRAVEL PACK INTERVALS:	From . . . 25	ft. to . . . 54	ft., From	ft. to	ft.
	From	ft. to	ft., From	ft. to	ft.

6 GROUT MATERIAL: 1 Neat cement 2 Cement grout 3 Bentonite 4 Other

Grout Intervals: From 5 ft. to 25 ft. From ft. to ft. From ft. to ft.

What is the nearest source of possible contamination:				10 Livestock pens	14 Abandoned water well
1 Septic tank	4 Lateral lines	7 Pit privy	11 Fuel storage	15 Oil well/Gas well	
2 Sewer lines	5 Cess pool	8 Sewage lagoon	12 Fertilizer storage	16 Other (specify below)	
3 Watertight sewer lines	6 Seepage pit	9 Feedyard	13 Insecticide storage		

Direction from well? West How many feet? 100 ft

[illegible]

7 CONTRACTOR'S OR LANDOWNER'S CERTIFICATION: This water well was (1) constructed, (2) reconstructed, or (3) plugged under my jurisdiction and was completed on (mo/day/year) 2-4-92 and this record is true to the best of my knowledge and belief. Kansas Water Well Contractor's License No. 138 This Water Well Record was completed on (mo/day/yr) 2-18-92 under the business name of Peterson Irrigation Inc. by (signature) Mike Peterson