


1 LOCATION OF WATER WELL: Fraction  $\frac{1}{4}$  E  $\frac{1}{2}$   $\frac{1}{4}$  SW  $\frac{1}{4}$  Section Number 6 Township Number T 21 S Range Number R 10  $\frac{1}{2}$ W  
 County: Rice

Distance and direction from nearest town or city street address of well if located within city?  
 From Raymond, Ks. 1 3/4 south, 2 1/2 West

2 WATER WELL OWNER: John Caywood  
 RR#, St. Address, Box #: 1845 8th St.  
 City, State, ZIP Code: Raymond, Ks. 67573  
 Board of Agriculture, Division of Water Resources  
 Application Number: WW-96-3

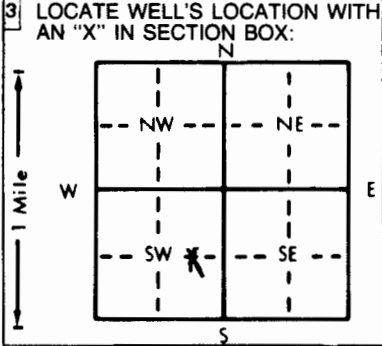

4 DEPTH OF COMPLETED WELL: 30 ft. ELEVATION:  
 Depth(s) Groundwater Encountered 1. .... ft. 2. .... ft. 3. .... ft.  
 WELL'S STATIC WATER LEVEL: 7 ft. below land surface measured on mo/day/yr 4-16-96  
 Pump test data: Well water was .... ft. after .... hours pumping .... gpm  
 Est. Yield: na gpm; Well water was .... ft. after .... hours pumping .... gpm  
 Bore Hole Diameter: .... in. to .... ft., and .... in. to .... ft.  
 WELL WATER TO BE USED AS:  
 5 Public water supply 8 Air conditioning 11 Injection well  
 1 Domestic 3 Feedlot 6 Oil field water supply 9 Dewatering 12 Other (Specify below)  
 2 Irrigation 4 Industrial 7 Lawn and garden only 10 Monitoring well live stock  
 Was a chemical/bacteriological sample submitted to Department? Yes.....No.....X; If yes, mo/day/yr sample was submitted  
 Water Well Disinfected? Yes No

5 TYPE OF BLANK CASING USED:  
 1 Steel 3 RMP (SR) 5 Wrought iron 8 Concrete tile CASING JOINTS: Glued .. X .. Clamped ..  
 2 PVC 4 ABS 6 Asbestos-Cement 9 Other (specify below) Welded ..  
 7 Fiberglass Threaded ..  
 Blank casing diameter: 5 in. to 20 ft., Dia. .... in. to .... ft., Dia. .... in. to .... ft.  
 Casing height above land surface: 2 in., weight: 2.58 lbs./ft. Wall thickness or gauge No. ....  
 TYPE OF SCREEN OR PERFORATION MATERIAL:  
 1 Steel 3 Stainless steel 5 Fiberglass 7 PVC 10 Asbestos-cement  
 2 Brass 4 Galvanized steel 6 Concrete tile 8 RMP (SR) 11 Other (specify) ..  
 12 None used (open hole)  
 SCREEN OR PERFORATION OPENINGS ARE:  
 1 Continuous slot 3 Mill slot 5 Gauzed wrapped 8 Saw cut 11 None (open hole)  
 2 Louvered shutter 4 Key punched 6 Wire wrapped 9 Drilled holes  
 7 Torch cut 10 Other (specify) ..  
 SCREEN-PERFORATED INTERVALS: From: 30 ft. to 20 ft., From .... ft. to .... ft.  
 GRAVEL PACK INTERVALS: From: 30 ft. to 12 ft., From .... ft. to .... ft.

6 GROUT MATERIAL: 1 Neat cement 2 Cement grout 3 Bentonite 4 Other hole plug  
 Grout Intervals: From: 12 ft. to 0 ft., From .... ft. to .... ft.  
 What is the nearest source of possible contamination:  
 1 Septic tank 4 Lateral lines 7 Pit privy 10 Livestock pens 14 Abandoned water well  
 2 Sewer lines 5 Cess pool 8 Sewage lagoon 11 Fuel storage 15 Oil well/Gas well  
 3 Watertight sewer lines 6 Seepage pit 9 Feedyard 12 Fertilizer storage 16 Other (specify below)  
 13 Insecticide storage  
 Direction from well? south How many feet? 700'

FROM	TO	LITHOLOGIC LOG	FROM	TO	PLUGGING INTERVALS
0	3	Top soil			
3	11	Brown clay			
11	17	Gray clay tough			
17	30	Sand and gravel clean, coarse, loose			

7 CONTRACTOR'S OR LANDOWNER'S CERTIFICATION: This water well was (1) constructed, (2) reconstructed, or (3) plugged under my jurisdiction and was completed on (mo/day/year) 4-16-96 and this record is true to the best of my knowledge and belief. Kansas Water Well Contractor's License No. 134 This Water Well Record was completed on (mo/day/yr) 4-30-96 under the business name of Rosencrantz-Bemis by (signature) Fredia Rodson