


1 LOCATION OF WATER WELL: County: <u>Rice</u>	Fraction <u>SE</u> $\frac{1}{4}$ <u>NW</u> $\frac{1}{4}$ <u>NW</u> $\frac{1}{4}$	Section Number <u>22</u>	Township Number <u>T</u> <u>21</u> <u>S</u>	Range Number <u>R</u> <u>10</u> <u>EW</u>
--	---	-----------------------------	--	--

Distance and direction from nearest town or city street address of well if located within city?  
4 1/4 south of Raymond, Ks.

2 WATER WELL OWNER: John Caywood  
 RR#, St. Address, Box # : 1845 8th Board of Agriculture, Division of Water Resources  
 City, State, ZIP Code : Raymond, Ks. 67573 Application Number:

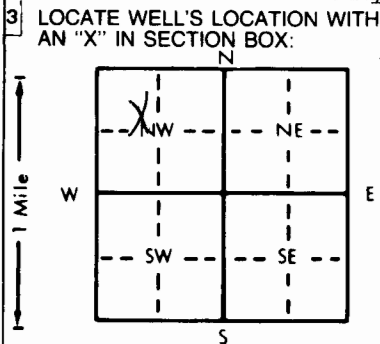

4 DEPTH OF COMPLETED WELL: 50 ft. ELEVATION:  
 Depth(s) Groundwater Encountered 1. 1 ft. 2.    ft. 3.    ft.  
 WELL'S STATIC WATER LEVEL 12 ft. below land surface measured on mo/day/yr 5-16-97  
 Pump test data: Well water was    ft. after    hours pumping    gpm  
 Est. Yield na gpm: Well water was    ft. after    hours pumping    gpm  
 Bore Hole Diameter 9 in. to 50 ft., and    in. to    ft.  
 WELL WATER TO BE USED AS:  
 5 Public water supply 8 Air conditioning 11 Injection well  
 1 Domestic 3 Feedlot 6 Oil field water supply 9 Dewatering 12 Other (Specify below)  
 2 Irrigation 4 Industrial 7 Lawn and garden only 10 Monitoring well stock  
 Was a chemical/bacteriological sample submitted to Department? Yes    No X; If yes, mo/day/yr sample was submitted     
 Water Well Disinfected? Yes hth No

5 TYPE OF BLANK CASING USED:  
 1 Steel 3 RMP (SR) 5 Wrought iron 8 Concrete tile CASING JOINTS: Glued X Clamped     
 2 PVC 4 ABS 6 Asbestos-Cement 9 Other (specify below) Welded     
 7 Fiberglass Threaded     
 Blank casing diameter 5 in. to 30 ft., Dia.    in. to    ft., Dia.    in. to    ft.  
 Casing height above land surface 2' in., weight SDR: 26 lbs./ft. Wall thickness or gauge No.     
 TYPE OF SCREEN OR PERFORATION MATERIAL:  
 1 Steel 3 Stainless steel 5 Fiberglass 7 PVC 10 Asbestos-cement  
 2 Brass 4 Galvanized steel 6 Concrete tile 8 RMP (SR) 11 Other (specify)     
 9 ABS 12 None used (open hole)  
 SCREEN OR PERFORATION OPENINGS ARE:  
 1 Continuous slot 5 Gauzed wrapped 8 Saw cut 11 None (open hole)  
 2 Louvered shutter 3 Mill slot 6 Wire wrapped 9 Drilled holes  
 4 Key punched 7 Torch cut 10 Other (specify)     
 SCREEN-PERFORATED INTERVALS: From 50 ft. to 30 ft., From    ft. to    ft.  
 From    ft. to    ft., From    ft. to    ft.  
 GRAVEL PACK INTERVALS: From 50 ft. to 12 ft., From    ft. to    ft.  
 From    ft. to    ft., From    ft. to    ft.

6 GROUT MATERIAL: 1 Neat cement 2 Cement grout 3 Bentonite 4 Other hole plug  
 Grout Intervals: From 12 ft. to 0 ft., From    ft. to    ft., From    ft. to    ft.  
 What is the nearest source of possible contamination:  
 1 Septic tank 4 Lateral lines 7 Pit privy 10 Livestock pens 14 Abandoned water well  
 2 Sewer lines 5 Cess pool 8 Sewage lagoon 11 Fuel storage 15 Oil well/Gas well  
 3 Watertight sewer lines 6 Seepage pit 9 Feedyard 12 Fertilizer storage 16 Other (specify below)  
 13 Insecticide storage  
 Direction from well? west How many feet? 600'

FROM	TO	LITHOLOGIC LOG	FROM	TO	PLUGGING INTERVALS
0	5	Sandy top soil			
5	15	Fine sand			
15	20	Dirty sand			
20	26	Brown clay			
26	50	Sand and gravel			

7 CONTRACTOR'S OR LANDOWNER'S CERTIFICATION: This water well was (1) constructed, (2) reconstructed, or (3) plugged under my jurisdiction and was completed on (mo/day/year) 5-16-97 and this record is true to the best of my knowledge and belief. Kansas Water Well Contractor's License No. 134 This Water Well Record was completed on (mo/day/yr) 6-4-97 under the business name of Rosencrantz-Bemis by (signature) Fredia Hudson

INSTRUCTIONS: Use typewriter or ball point pen. PLEASE PRESS FIRMLY and PRINT clearly. Please fill in blanks, underline or circle the correct answers. Send top three copies to Kansas Department of Health and Environment, Bureau of Water, Topeka, Kansas 66620-0001. Telephone: 913-296-5545. Send one to WATER WELL OWNER and retain one for your records.

OFFICE USE ONLY  
T  
R  
EW  
SEC.  
1/4  
1/4  
1/4