



ASSIGNMENT OF WATER WELL TO LANDOWNER

I, Carmen Schmitt of P.O. Box 47  
(Landowner's address)

Great Bend, Kansas am the landowner on which a water well is located in  
(City) (State)  
the 1 SE quarter of the NW quarter of the SE quarter in Section 24, Township 21S,  
Range 10 E/W, in Rice County, Kansas which is approximately  
1650 feet north/south, and 1650 feet east/west of the apparent southeast section  
corner. The water well was drilled in June 2011 (month/year).

I hereby request that Carmen Schmitt, Inc leave the water well,  
(Operator name)

which was drilled by Temporary Water Permit # 20110270, unplugged, and I will  
assume all responsibility for the plugging of said water well in accordance with the requirements  
of the Kansas Department of Health and Environment regulation K.A.R. 28-30-7.

LANDOWNER:

OPERATOR:

Carmen Schmitt 7-21-11  
(Signature) (Date)

Carmen Schmitt 7-21-11  
(Signature) (Date)

Carmen Schmitt  
(Print)

By: Carmen Schmitt  
(Agent)

IF ADDITIONAL LANDOWNER

\_\_\_\_\_  
(Signature) (Date)

\_\_\_\_\_  
(Print)

WATER WELL RECORD


Form WWC-5

Division of Water Resources App. No.

1 LOCATION OF WATER WELL: County: Rice, Fraction: 1/4 SE 1/4 NW 1/4 SE 1/4, Section Number: 24, Township No.: T 21 S, Range Number: R 10, E/W: [ ] E [x] W

Street/Rural Address of Well Location; if unknown, distance & direction from nearest town or intersection: 3 West, 1 3/4 South of Alden. Global Positioning System (GPS) information: Latitude: ..., Longitude: ..., Elevation: ..., Datum: [ ] WGS 84, [ ] NAD 83, [ ] NAD 27

2 WATER WELL OWNER: Carmen Schmitt, RR#, Street Address, Box #: P.O. Box 47, City, State, ZIP Code: Great Bend, Ks. 67530. Collection Method: [ ] GPS unit, [ ] Digital Map/Photo, [ ] Topographic Map, [ ] Land Survey

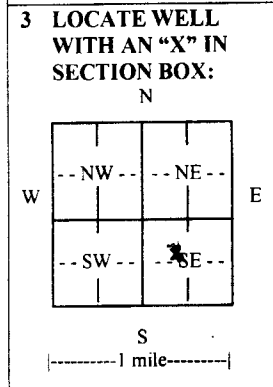

3 LOCATE WELL WITH AN 'X' IN SECTION BOX: N, S, E, W. 4 DEPTH OF COMPLETED WELL 60 ft. Depth(s) Groundwater Encountered (1)..... ft. (2)..... ft. (3)..... ft. WELL'S STATIC WATER LEVEL 6 ft. below land surface measured on mo/day/yr. 6-22-11. Pump test data: Well water was.....ft. after..... hours pumping..... gpm. EST. YIELD N/A gpm. Well water was.....ft. after..... hours pumping..... gpm. Bore Hole Diameter 10 in. to 60 ft., and.....in. to.....ft. WELL WATER TO BE USED AS: [ ] Public water supply, [ ] Geothermal, [ ] Injection well, [ ] Domestic, [ ] Feedlot, [x] Oil field water supply, [ ] Dewatering, [ ] Other (Specify below), [ ] Irrigation, [ ] Industrial, [ ] Domestic-lawn & garden, [ ] Monitoring well. Was a chemical/bacteriological sample submitted to Department? [ ] Yes [x] No. If yes, mo/day/yr sample was submitted..... Water well disinfected? [x] Yes [ ] No

5 TYPE OF CASING USED: [ ] Steel [x] PVC [ ] Other. CASING JOINTS: [x] Glued [ ] Clamped [ ] Welded [ ] Threaded. Casing diameter 5 in. to 60 ft., Diameter..... in. to..... ft., Diameter..... in. to..... ft. Casing height above land surface 18 in., Weight SDR: 26 lbs./ft., Wall thickness or gauge No. TYPE OF SCREEN OR PERFORATION MATERIAL: [ ] Steel, [ ] Stainless Steel, [x] PVC, [ ] Brass, [ ] Galvanized Steel, [ ] None used (open hole), [ ] Other (Specify). SCREEN OR PERFORATION OPENINGS ARE: [ ] Continuous slot, [ ] Mill slot, [ ] Gauze wrapped, [ ] Torch cut, [ ] Drilled holes, [ ] None (open hole), [ ] Louvered shutter, [ ] Key punched, [ ] Wire wrapped, [x] Saw cut, [ ] Other (specify). SCREEN-PERFORATED INTERVALS: From 60 ft. to 40 ft., From..... ft. to..... ft., From..... ft. to..... ft. GRAVEL PACK INTERVALS: From 60 ft. to 20 ft., From..... ft. to..... ft., From..... ft. to..... ft.

6 GROUT MATERIAL: [ ] Neat cement, [ ] Cement grout, [x] Bentonite, [ ] Other. Grout Intervals: From..... ft. to..... ft., From 20 ft. to 0 ft., From..... ft. to..... ft. What is the nearest source of possible contamination: [ ] Septic tank, [ ] Lateral lines, [ ] Pit privy, [ ] Livestock pens, [ ] Insecticide storage, [x] Other (specify below), [ ] Sewer lines, [ ] Cesspool, [ ] Sewage lagoon, [ ] Fuel storage, [ ] Abandoned water well, [ ] Watertight sewer lines, [ ] Seepage pit, [ ] Feedyard, [ ] Fertilizer storage, [ ] Oil well/gas well, River. Direction from well North, Distance from well 1000.

Table with 6 columns: FROM, TO, LITHOLOGIC LOG, FROM, TO, LITHO. LOG (cont.) or PLUGGING INTERVALS. Rows include: 0-3 Sandy top soil, 3-11 Gray & tan clay, 11-60 Sand & gravel- med, loose, coarse, & clean.

7 CONTRACTOR'S OR LANDOWNER'S CERTIFICATION: This water well was [x] constructed, [ ] reconstructed, or [ ] plugged under my jurisdiction and was completed on (mo/day/year) 6-22-11..... and this record is true to the best of my knowledge and belief. Kansas Water Well Contractor's License No. 134..... This Water Well Record was completed on (mo/day/year) 7-2-11..... under the business name of Rosenkrantz Bemis..... by (signature) [Signature]

INSTRUCTIONS: Use typewriter or ball point pen. PLEASE PRESS FIRMLY and PRINT clearly. Please fill in blanks and check the correct answers. Send three copies (white, blue, pink) to Kansas Department of Health and Environment, Bureau of Water, Geology Section, 1000 SW Jackson St., Suite 420, Topeka, Kansas 66612-1367. Telephone 785-296-5522. Send one copy to WATER WELL OWNER and retain one for your records. Include fee of \$5.00 for each constructed well. Visit us at http://www.kdheks.gov/waterwell/index.html.