


WATER WELL RECORD Form WWC-5 KSA 82a-1212

1 LOCATION OF WATER WELL: County: Rice	Fraction SW 1/4 NE 1/4 NW 1/4	Section Number 12	Township Number T 21 S	Range Number R 10 EW
--	----------------------------------	----------------------	---------------------------	-------------------------

Distance and direction from nearest town or city street address of well if located within city?
Approx. 3 miles west and 1/2 mi. south of Alden, KS

2 WATER WELL OWNER: RR#, St. Address, Box # : City, State, ZIP Code :	Harold Ricker Route 1 - Box 9 Raymond, KS 67573	Board of Agriculture, Division of Water Resources Application Number: n/a
--	---	--

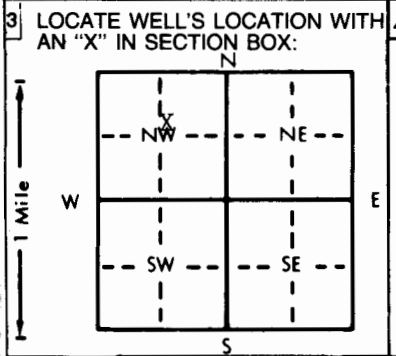

4 DEPTH OF COMPLETED WELL: 29 ft. ELEVATION: unknown
Depth(s) Groundwater Encountered 1. 7 ft. 2. . ft. 3. . ft.
WELL'S STATIC WATER LEVEL . . . 7 . ft. below land surface measured on mo/day/yr . . . 10-15-84
Pump test data: Well water was not ck'd ft. after hours pumping gpm
Est. Yield* 1100 . . . gpm: Well water was ft. after hours pumping gpm
Bore Hole Diameter . . . 24 . . in. to . . . 29 . . . ft., and in. to ft.
WELL WATER TO BE USED AS:
5 Public water supply 8 Air conditioning 11 Injection well
1 Domestic 3 Feedlot 6 Oil field water supply 9 Dewatering 12 Other (Specify below)
2 Irrigation 4 Industrial 7 Lawn and garden only 10 Observation well
Was a chemical/bacteriological sample submitted to Department? Yes No . . . X ; If yes, mo/day/yr sample was submitted
Water Well Disinfected? Yes No X

5 TYPE OF BLANK CASING USED:	5 Wrought iron	8 Concrete tile	CASING JOINTS: Glued Clamped	
1 Steel	3 RMP (SR)	6 Asbestos-Cement	9 Other (specify below)	Welded XX
2 PVC	4 ABS	7 Fiberglass		Threaded
Blank casing diameter 16 . . . in. to . . . 17 . . . ft., Dia 16 . . . in. to . . . 29 . . . ft., Dia in. to ft.				
Casing height above land surface 12 . . . in., weight 36.87 lbs./ft. Wall thickness or gauge No. . . . 219				

TYPE OF SCREEN OR PERFORATION MATERIAL:	7 PVC	10 Asbestos-cement		
1 Steel	3 Stainless steel	5 Fiberglass	8 RMP (SR)	11 Other (specify)
2 Brass	4 Galvanized steel	6 Concrete tile	9 ABS	12 None used (open hole)

SCREEN OR PERFORATION OPENINGS ARE:	5 Gauzed wrapped	8 Saw cut	11 None (open hole)
1 Continuous slot	3 Mill slot	6 Wire wrapped	9 Drilled holes
2 Louvered shutter	4 Key punched	7 Torch cut	10 Other (specify) .. Doerr Bridge Slot

SCREEN-PERFORATED INTERVALS: From 17 ft. to 25 ft., From ft. to ft.
From ft. to ft., From ft. to ft.
GRAVEL PACK INTERVALS: From 10 ft. to 29 ft., From ft. to ft.
From ft. to ft., From ft. to ft.

6 GROUT MATERIAL: 1 Neat cement 2 Cement grout 3 Bentonite 4 Other				
Grout intervals: From 0 . . . ft. to . . . 10 . . . ft., From ft. to ft., From ft. to ft.				
What is the nearest source of possible contamination:	10 Livestock pens	14 Abandoned water well		
1 Septic tank	4 Lateral lines	7 Pit privy	11 Fuel storage	15 Oil well/Gas well
2 Sewer lines	5 Cess pool	8 Sewage lagoon	12 Fertilizer storage	16 Other (specify below)
3 Watertight sewer lines	6 Seepage pit	9 Feedyard	13 Insecticide storage	FIELD
Direction from well? all			How many feet?	

FROM	TO	LITHOLOGIC LOG	FROM	TO	LITHOLOGIC LOG
0	3	Topsoil			
3	24	Sand & gravel, med. to coarse			
24	28	Tan clay			
28	29	Sand & gravel			

7 CONTRACTOR'S OR LANDOWNER'S CERTIFICATION: This water well was (1) constructed, (2) reconstructed, or (3) plugged under my jurisdiction and was completed on (mo/day/year) 10-15-84 and this record is true to the best of my knowledge and belief. Kansas Water Well Contractor's License No. 185 This Water Well Record was completed on (mo/day/yr) 1-17-85 under the business name of Clarke Well & Eq., Inc. by (signature) [Signature]

INSTRUCTIONS: Use typewriter or ball point pen, PLEASE PRESS FIRMLY and PRINT clearly. Please fill in blanks, underline or circle the correct answers. Send top three copies to Kansas Department of Health and Environment, Division of Environment, Environmental Geology Section, Topeka, KS 66620. Send one to WATER WELL OWNER and retain one for your records.