


1 LOCATION OF WATER WELL: County: Stafford Fraction: NE 1/4 NE 1/4 SE 1/4 Section Number: 10 Township Number: T 21 S Range Number: R 11W EW

Distance and direction from nearest town or city street address of well if located within city?  
8N, 7E of Hudson, KS

2 WATER WELL OWNER: James A. Sleeper Sterling Drilling Co. Sleeper A1-10  
 RR#, St. Address, Box # 1029 W 49th Terrace Box 1006  
 City, State, ZIP Code Shawnee Mission, KS 66205 Pratt, Ks. 67124 Board of Agriculture, Division of Water Resources  
 Application Number: \_\_\_\_\_

3 LOCATE WELL'S LOCATION WITH AN "X" IN SECTION BOX:

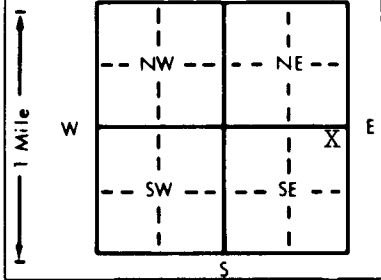

4 DEPTH OF COMPLETED WELL: 50 ft. ELEVATION: \_\_\_\_\_  
 Depth(s) Groundwater Encountered 1. \_\_\_\_\_ ft. 2. \_\_\_\_\_ ft. 3. \_\_\_\_\_ ft.  
 WELL'S STATIC WATER LEVEL 16 ft. below land surface measured on mo/day/yr 3-15-97  
 Pump test data: Well water was \_\_\_\_\_ ft. after \_\_\_\_\_ hours pumping \_\_\_\_\_ gpm  
 Est. Yield \_\_\_\_\_ gpm: Well water was \_\_\_\_\_ ft. after \_\_\_\_\_ hours pumping \_\_\_\_\_ gpm  
 Bore Hole Diameter \_\_\_\_\_ in. to \_\_\_\_\_ ft., and \_\_\_\_\_ in. to \_\_\_\_\_ ft.  
 WELL WATER TO BE USED AS:  
 1 Domestic  3 Feedlot  5 Public water supply  8 Air conditioning  11 Injection well   
 2 Irrigation  4 Industrial  7 Lawn and garden only  9 Dewatering  12 Other (Specify below) \_\_\_\_\_  
 Was a chemical/bacteriological sample submitted to Department? Yes \_\_\_\_\_ No \_\_\_\_\_; If yes, mo/day/yr sample was submitted \_\_\_\_\_  
 Water Well Disinfected? Yes \_\_\_\_\_ No \_\_\_\_\_

5 TYPE OF BLANK CASING USED:  
 1 Steel \_\_\_\_\_ 3 RMP (SR) \_\_\_\_\_ 5 Wrought iron \_\_\_\_\_ 8 Concrete tile \_\_\_\_\_ CASING JOINTS: Glued \_\_\_\_\_ Clamped \_\_\_\_\_  
 2 PVC \_\_\_\_\_ 4 ABS \_\_\_\_\_ 6 Asbestos-Cement \_\_\_\_\_ 9 Other (specify below) \_\_\_\_\_ Welded \_\_\_\_\_  
 7 Fiberglass \_\_\_\_\_ Threaded \_\_\_\_\_  
 Blank casing diameter 5 in. to 20 ft., Dia \_\_\_\_\_ in. to \_\_\_\_\_ ft., Dia \_\_\_\_\_ in. to \_\_\_\_\_ ft.  
 Casing height above land surface 3 ft below in., weight \_\_\_\_\_ lbs./ft. Wall thickness or gauge No. \_\_\_\_\_  
 TYPE OF SCREEN OR PERFORATION MATERIAL:  
 1 Steel \_\_\_\_\_ 3 Stainless steel \_\_\_\_\_ 5 Fiberglass \_\_\_\_\_ 8 RMP (SR) \_\_\_\_\_ 10 Asbestos-cement \_\_\_\_\_  
 2 Brass \_\_\_\_\_ 4 Galvanized steel \_\_\_\_\_ 6 Concrete tile \_\_\_\_\_ 9 ABS \_\_\_\_\_ 11 Other (specify) \_\_\_\_\_  
 12 None used (open hole) \_\_\_\_\_  
 SCREEN OR PERFORATION OPENINGS ARE:  
 1 Continuous slot \_\_\_\_\_ 3 Mill slot \_\_\_\_\_ 5 Gauzed wrapped \_\_\_\_\_ 8 Saw cut \_\_\_\_\_ 11 None (open hole) \_\_\_\_\_  
 2 Louvered shutter \_\_\_\_\_ 4 Key punched \_\_\_\_\_ 6 Wire wrapped \_\_\_\_\_ 9 Drilled holes \_\_\_\_\_  
 7 Torch cut \_\_\_\_\_ 10 Other (specify) \_\_\_\_\_  
 SCREEN-PERFORATED INTERVALS: From \_\_\_\_\_ ft. to \_\_\_\_\_ ft., From \_\_\_\_\_ ft. to \_\_\_\_\_ ft., From \_\_\_\_\_ ft. to \_\_\_\_\_ ft.  
 GRAVEL PACK INTERVALS: From 20 ft. to 50 ft., From \_\_\_\_\_ ft. to \_\_\_\_\_ ft., From \_\_\_\_\_ ft. to \_\_\_\_\_ ft.

6 GROUT MATERIAL: 1 Neat cement \_\_\_\_\_ 2 Cement grout \_\_\_\_\_ 3 Bentonite \_\_\_\_\_ 4 Other \_\_\_\_\_  
 Grout Intervals: From \_\_\_\_\_ ft. to \_\_\_\_\_ ft., From \_\_\_\_\_ ft. to \_\_\_\_\_ ft., From \_\_\_\_\_ ft. to \_\_\_\_\_ ft.  
 What is the nearest source of possible contamination:  
 1 Septic tank \_\_\_\_\_ 4 Lateral lines \_\_\_\_\_ 7 Pit privy \_\_\_\_\_ 10 Livestock pens \_\_\_\_\_ 14 Abandoned water well \_\_\_\_\_  
 2 Sewer lines \_\_\_\_\_ 5 Cess pool \_\_\_\_\_ 8 Sewage lagoon \_\_\_\_\_ 11 Fuel storage \_\_\_\_\_ 15 Oil well/Gas well \_\_\_\_\_  
 3 Watertight sewer lines \_\_\_\_\_ 6 Seepage pit \_\_\_\_\_ 9 Feedyard \_\_\_\_\_ 12 Fertilizer storage \_\_\_\_\_ 16 Other (specify below) \_\_\_\_\_  
 13 Insecticide storage \_\_\_\_\_  
 Direction from well? \_\_\_\_\_ How many feet? \_\_\_\_\_

FROM	TO	LITHOLOGIC LOG	FROM	TO	PLUGGING INTERVALS
			50	16	Sand and gravel
			16	3	Bentonite
			3	0	Top soil

7 CONTRACTOR'S OR LANDOWNER'S CERTIFICATION: This water well was (1) constructed, (2) reconstructed, or (3) plugged under my jurisdiction and was completed on (mo/day/year) 3-15-97 and this record is true to the best of my knowledge and belief. Kansas Water Well Contractor's License No. 186. This Water Well Record was completed on (mo/day/yr) 3-19-97 under the business name of Kelly's Water Well Service Inc. by (signature) Kathryn Good

OFFICE USE ONLY

T

R

EW

SEC.

1/4

1/4

1/4