

1 LOCATION OF WATER WELL:	Fraction	Section Number	Township Number	Range Number
County: Stafford	SE ¼ NW ¼ SW ¼	2	T 21 S	R 11W E/W


Distance and direction from nearest town or city street address of well if located within city?

9N, 8E of Hudson, KS

2	WATER WELL OWNER: Warren Rugan	Sterling Drilling Co.	Rugan GI-2
	RR#, St. Address, Box # : 510 W. 4th	P. O. Box 1006	Board of Agriculture, Division of Water Resources
	City, State, ZIP Code : Ellinwood, Ks. 67526	Pratt, KS 67124	Application Number: 990250

3 LOCATE WELL'S LOCATION WITH AN "X" IN SECTION BOX:

4 DEPTH OF COMPLETED WELL... 67 ft. ELEVATION: unknown

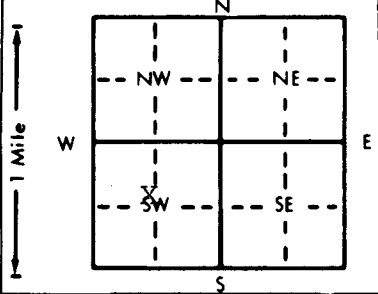

Depth(s) Groundwater Encountered 1. ... 15. ... ft. 2. ... ft. 3. ... ft.
WELL'S STATIC WATER LEVEL ... 15. ... ft. below land surface measured on mo/day/yr 12/08/99

Pump test data: Well water was ft. after hours pumping gpm
 Est. Yield . . 40 . . . gpm: Well water was ft. after hours pumping gpm
 Bore Hole Diameter . . 8 . . . in. to . . 67 . . . ft., and in. to ft.

WELL WATER TO BE USED AS:		5 Public water supply	8 Air conditioning	11 Injection well
1 Domestic	3 Feedlot	<u>6 Oil field water supply</u>	9 Dewatering	12 Other (Specify below)
2 Irrigation	4 Industrial	7 Lawn and garden only	10 Monitoring well	

Was a chemical/bacteriological sample submitted to Department? Yes.....No.....; If yes, mo/day/yr sample was submitted.....
 Water Well Disinfected? Yes..... No.....

5	TYPE OF BLANK CASING USED:		5 Wrought iron	8 Concrete tile	CASING JOINTS: <u>Glued</u> Clamped Welded Threaded
	1 Steel	3 RMP (SR)	6 Asbestos-Cement	9 Other (specify below)	
	2 PVC	4 ABS	7 Fiberglass		

Blank casing diameter 5 in. to 47 ft. Dia in. to ft. Dia in. to ft.
Casing height above land surface 12 in. weight 2.8 lbs./ft. Wall thickness or gauge No. Sch. 40

TYPE OF SCREEN OR PERFORATION MATERIAL:					
1 Steel	3 Stainless steel	5 Fiberglass	7 <u>PVC</u>	10 Asbestos-cement	
2 Brass	4 Galvanized steel	6 Concrete tile	8 <u>RMP (SR)</u>	11 Other (specify)	
			9 ABS	12 None used (open hole)	

SCREEN OR PERFORATION OPENINGS ARE:			
1 Continuous slot	3 Mill slot	5 Gauzed wrapped	8 <u>Saw cut</u>
2 Louvered shutter	4 Key punched	6 Wire wrapped	9 Drilled holes
		7 Torch cut	10 Other (specify)
			11 None (open hole)

SCREEN-PERFORATED INTERVALS:	From	47	ft. to	67	ft., From	ft. to	ft.
	From		ft. to		ft., From	ft. to	ft.
GRAVEL PACK INTERVALS:	From	20	ft. to	67	ft., From	ft. to	ft.
	From		ft. to		ft., From	ft. to	ft.

6 GROUT MATERIAL: 1 Neat cement 2 Cement grout 3 Bentonite 4 Other

Grout Intervals: From 0 ft. to 20 ft. From ft. to ft. From ft. to ft.

What is the nearest source of possible contamination:

1 Septic tank	4 Lateral lines	7 Pit privy	10 Livestock pens	14 Abandoned water well
2 Sewer lines	5 Cess pool	8 Sewage lagoon	11 Fuel storage	<u>15 Oil well/Gas well</u>
3 Watertight sewer lines	6 Seepage pit	9 Feedyard	12 Fertilizer storage	16 Other (specify below)

Direction from well? West

How many feet? 130

[illegible]

7. CONTRACTOR'S OR LANDOWNER'S CERTIFICATION: This water well was (1) constructed, (2) reconstructed, or (3) plugged under my jurisdiction and was completed on (mo/day/year) 12/08/99 and this record is true to the best of my knowledge and belief. Kansas Water Well Contractor's License No. 186 This Water Well Record was completed on (mo/day/yr) 12/09/99 under the business name of Kelly's Water Well Service, Inc. by (signature) [Signature]