


1 LOCATION OF WATER WELL: Fraction NE Section Number 13 Township Number 21 Range Number 11E
 County: LYON $\frac{1}{4}$ $\frac{1}{4}$

Distance and direction from nearest town or city street address of well if located within city?
N/A

2 WATER WELL OWNER: LARRY MILNER
 RR #, St. Address, Box #: 1261 Rd 50 Olpeks Board of Agriculture, Division of Water Resources
 City, State, ZIP Code: 1261 Rd 50 Olpeks Application Number: _____

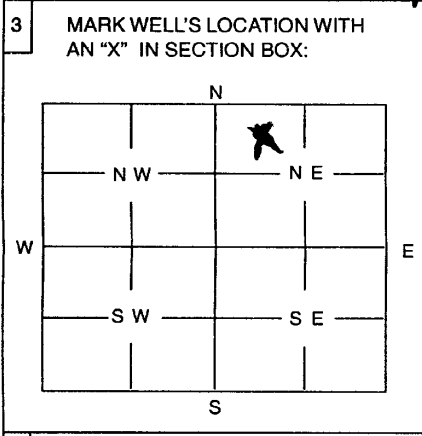

4 DEPTH OF WELL 23 ft
 WELL'S STATIC WATER LEVEL 18 ft
 WELL WAS USED AS:
 1 Domestic 5 Public Water Supply 9 Dewatering
 2 Irrigation 6 Oil Field Water Supply 10 Monitoring Well
 3 Feedlot 7 Domestic (Lawn & Garden) 11 Injection Well
 4 Industrial 8 Air Conditioning 12 Other
 Was a chemical / bacteriological sample submitted to Department? Yes No
 If yes, mo/day/yr sample was submitted
 Water Well Disinfected: Yes No

5 TYPE OF BLANK CASING USED:
 1 Steel 3 RMP (SR) 5 Wrought 7 Fiberglass 9 Other (Specify below) Rock
 2 PVC 4 ABS 6 Asbestos-Cement 8 Concrete Tile
 Blank casing diameter 36 in. Was casing pulled? Yes No If yes, how much 5 ft.
 Casing height above or below land surface 60 in.

6 GROUT PLUG MATERIAL: 1 Neat cement 2 Cement grout 3 Bentonite 4 Other
 Grout Plug Intervals: From 5 ft. to 4.5 ft., From ft. to ft., From to ft.
 What is the nearest source of possible contamination:
 1 Septic tank 6 Seepage pit 11 Fuel storage 16 Other (specify below)
 2 Sewer lines 7 Pit privy 12 Fertilizer storage
 3 Watertight sewer lines 8 Sewage lagoon 13 Insecticide storage
 4 Lateral lines 9 Feedyard 14 Abandoned water well
 5 Cess Pool 10 Livestock pens 15 Oil well/Gas well
 Direction from well? SW How many feet? 30

FROM	TO	PLUGGING MATERIALS
<u>23</u>	<u>5</u>	<u>Rock</u>
<u>5</u>	<u>4.5</u>	<u>Bentonite</u>
<u>4.5</u>	<u>0</u>	<u>Top Soil</u>

7 CONTRACTOR'S OR LANDOWNER'S CERTIFICATION: This water well was plugged under my jurisdiction and was completed on (mo/day/year) Aug 24 2005 and this record is true to the best of my knowledge and belief. Kansas Water Well Contractor's License No. This Water Well Record was completed on (mo/day/year)
 by (signature) Larry Milner under the business name of

INSTRUCTIONS: Use typewriter or ball point pen. Please press firmly and print clearly. Please fill in blanks, underline or circle the correct answers. Send top three copies to Kansas Department of Health and Environment, Bureau of Water, Topeka, Kansas 66620-0001. Telephone: 785/296-3565. Send one to Water Well Owner and retain one for your records.