

1	LOCATION OF WATER WELL:	Fraction	NE NE	SW	Section Number	Township Number	Range Number
	County: Stafford	2310 S4	2970 EL 1/4	SE 1/4	5	T 21 S	R 11W E/W


Distance and direction from nearest town or city street address of well if located within city?

13 E. 5 N of Seward, Kansas

2	WATER WELL OWNER:	Leonard Kasselmann	Mohawk Drilling	Kasselmann No. 1
	RR#, St. Address, Box # :	Route 2	614 Patton Road	Board of Agriculture, Division of Water Resources
	City, State, ZIP Code :	Ellinwood, Ks. 67526	Great Bend, Ks. 67530	Application Number: Unknown

3 LOCATE WELL'S LOCATION WITH AN "X" IN SECTION BOX:

4 DEPTH OF COMPLETED WELL... 86 ..... ft. ELEVATION: .. Unknown

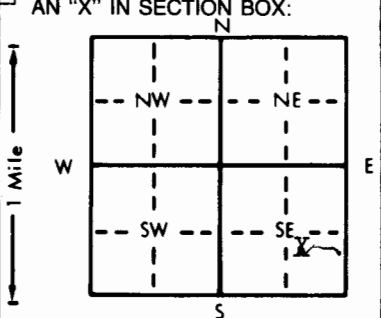

Depth(s) Groundwater Encountered 1. 30. . . . . ft. 2. . . . . ft. 3. . . . . ft.

WELL'S STATIC WATER LEVEL . . . . . 30. ft. below land surface measured on mo/day/yr . . . . . 10/23/84. . . . .

Pump test data: Well water was . . . . . ft. after . . . . . hours pumping . . . . . gpm

Est. Yield . . 60. . . . . gpm: Well water was . . . . . ft. after . . . . . hours pumping . . . . . gpm

Bore Hole Diameter. . . . 8. . . . in. to 86. . . . . ft., and. . . . . in. to . . . . . ft.

WELL WATER TO BE USED AS:

1 Domestic	3 Feedlot	6 <u>Oil field water supply</u>	9 Dewatering	12 Other (Specify below)
2 Irrigation	4 Industrial	7 <u>Lawn and garden only</u>	10 Observation well	

Was a chemical/bacteriological sample submitted to Department? Yes. . . . . No . . . . .; If yes, mo/day/yr sample was submitted

Water Well Disinfected? Yes . . . . . No . . . . .

5 TYPE OF BLANK CASING USED:

1 Steel	3 RMP (SR)	6 Asbestos-Cement	9 Other (specify below)	<u>Welded</u> . . . . .
2 <u>PVC</u>	4 ABS	7 Fiberglass		Threaded . . . . .

Blank casing diameter . . . . . 5 . . . . in. to . . . . 66 . . . . ft., Dia . . . . in. to . . . . ft., Dia . . . . in. to . . . . ft.  
Casing height above land surface . . . . 12 in., weight . . . . 2.8 lbs./ft. Wall thickness or gauge No. . . . Sch. 40

TYPE OF SCREEN OR PERFORATION MATERIAL:

1 Steel	3 Stainless steel	5 Fiberglass	8 <u>RMP</u> (SR)	11 Other (specify) . . . . .
2 Brass	4 Galvanized steel	6 Concrete tile	9 ABS	12 None used (open hole)

SCREEN OR PERFORATION OPENINGS ARE:

SCREEN OR PERFORATION OPENINGS ARE:

1 Continuous slot	3 Mill slot	5 Gauzed wrapped	8 <u>Saw cut</u>	11 None (open hole)
2 Louvered shutter	4 Key punched	6 Wire wrapped	9 Drilled holes	
		7 Torch cut	10 Other (specify) .....	

SCREEN-PERFORATED INTERVALS: From 66 ft. to 86 ft., From 11 ft. to 11 ft.  
From ft. to ft. From ft. to ft.

GRAVEL PACK INTERVALS: From .....10..... ft. to ...86..... ft., From ..... ft. to ..... ft.  
From ..... ft. to ..... ft., From ..... ft. to ..... ft.

6 GROUT MATERIAL: 1 Neat cement 2 Cement grout 3 Bentonite 4 Other

Grout Intervals: From 0 ft. to 10 ft. From ft. to ft. From ft. to ft. From ft. to ft.

**What is the nearest source of possible contamination:**

1 Septic tank	4 Lateral lines	7 Pit privy	11 Fuel storage	15 <u>Oil well/Gas well</u>
2 Sewer lines	5 Cess pool	8 Sewage lagoon	12 Fertilizer storage	16 Other (specify below)
3 Watertight sewer lines	6 Seepage pit	9 Feedyard	13 Insecticide storage	.....

Direction from well? South How many feet? 60

[illegible]

7 CONTRACTOR'S OR LANDOWNER'S CERTIFICATION: This water well was (1) constructed, (2) reconstructed, or (3) plugged under my jurisdiction and was completed on (mo/day/year) .. 10/23/84 ..... and this record is true to the best of my knowledge and belief, Kansas

Water Well Contractor's License No. 186 This Water Well Record was completed on (mo/day/yr) 11/19/84  
under the business name of Kellys Water Well Service by (signature) [Signature]

INSTRUCTIONS: Use typewriter or ball point pen, PLEASE PRESS FIRMLY and PRINT clearly. Please fill in blanks, underline or circle the correct answers. Send top three copies to Kansas Department of Health and Environment, Division of Environment, Environmental Geology Section, Topeka, KS 66620. Send one to WATER WELL OWNER and retain one for your records.