USE TYPEWRITER OR BALL POINT PEN-PRESS FIRMLY, PRINT CLEARLY.

WATER WELL RECORD
KSA 82a-1201-1215

Kansas Department of Health and Environment-Division of Environment
(Water well Contractors)
Topeka, Kansas 66620

1. Location of well:	County	Fraction	Section number	Township number	Range number
	Stafford	1/4 C 1/4 NW 1/4	6	T 21 S	R 11 E/W

2. Distance and direction from nearest town or city:
6 South $\frac{1}{4}$ West $\frac{1}{4}$ South of Ellinwood
Street address of well location if in city:

3. Owner of well: Stanley Donnebohm
R.R. or street:
City, state, zip code: Ellinwood, Ks.

4. Locate with "X" in section below: Sketch map:

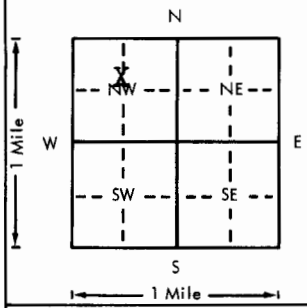

6. Bore hole dia. 29 in. Completion date
Well depth 140 ft. 9-27-76

7. __ Cable tool X Rotary __ Driven __ Dug
__ Hollow rod __ Jetted __ Bored __ Reverse rotary

8. Use: __ Domestic __ Public supply __ Industry
X Irrigation __ Air conditioning __ Stock
__ Lawn __ Oil field water __ Other

9. Casing: Material steel Height: Above or ~~below~~
Threaded ___ Welded X Surface 18 in.
RMP ___ PVC ___ Weight ___ lbs./ft.
Dia. 16 in. to 140 ft. depth Wall Thickness: inches or
Dia. ___ in. to ___ ft. depth gage No. 7

5. Type and color of material	From	To
Sandy top soil	0	3
Fine sand	3	9
Fine Sand and gray clay	9	11
Gray clay	11	24
Gray and brown clay	24	27
Brown clay	27	49
Brown clay some sand and gravel	49	56
Sand and gravel some clay mixed	56	62
Gravel good clean coarse	62	68
Sand and gravel lot of clay mixed	68	74
Fine sand and gravel clay mixed	74	89
Sand & gravel medium some clay mixed	89	94
Gravel clean coarse	94	116
Sand and gravel medium	116	125
Sand and gravel medium & fine	125	140
Hard gray clay (Use a second sheet if needed)	140	142½

10. Screen: Manufacturer's name Doerrs
Type steel Dia. 16
Slot/~~gauge~~ 3/16 Length 48
Set between 92 ft. and 140 ft.
___ ft. and ___ ft.
Gravel pack? X Size range of material ½ ¾ ⅜

11. Static water level: mo./day/yr.
32 ft. below land surface Date 8-11-76

12. Pumping level below land surfaces:
38 ft. after 1 hrs. pumping 1000 g.p.m.
___ ft. after ___ hrs. pumping ___ g.p.m.
Estimated maximum yield 1200 g.p.m.

13. Water sample submitted: mo./day/yr.
X Yes ___ No Date 9-11-76

14. Well head completion:
___ Pitless adapter ___ Inches above grade

15. Well grouted? X
With: ___ Neat cement ___ Bentonite X Concrete
Depth: From 0 ft. to 10 ft.

16. Nearest source of possible contamination:
ft. 4 Direction West Type Feed Lot
Well disinfected upon completion? ___ Yes ___ No

17. Pump: ___ Not installed
Manufacturer's name WLR
Model number 5-BHC-12 HP 75 Volts ___
Length of drop pipe 100 ft. capacity 1000 g.p.m.
Type:
___ Submersible X Turbine
___ Jet ___ Reciprocating
___ Centrifugal ___ Other

18. Elevation:
Topography:
___ Hill
X Slope
___ Upland
___ Valley

19. Remarks:

20. Water well contractor's certification:
This well was drilled under my jurisdiction and this report is true to the best of my knowledge and belief.
Rosencrantz-Bemis 134
Business name License No.
Address Great Bend, Ks.
Signed Fredia Dodson Date 9/30/76
Authorized representative

21 T 11 R 16 E/W Sec 1/4 1/4 1/4 C NW

Forward the white, blue and pink copies to the Department of Health and Environment

Form WWC-5

MI-1023