


WATER WELL RECORD Form WWC-5 KSA 82a-1212

1 LOCATION OF WATER WELL:	Fraction	Section Number	Township Number	Range Number
County: <u>Stafford</u>	<u>SW</u> $\frac{1}{4}$ <u>SW</u> $\frac{1}{4}$ <u>SE</u> $\frac{1}{4}$	<u>7</u>	<u>T 21</u> <u>S</u>	<u>R 11W</u> <u>E/W</u>

Distance and direction from nearest town or city street address of well if located within city?
5 E, 9 N of Hudson, Kansas

2 WATER WELL OWNER: <u>Roy Schloctermeier</u>	Sterling Drilling Co.	Schloctermeier 2-7
RR#, St. Address, Box # : <u>Route 1</u>	<u>Box 129</u>	Board of Agriculture, Division of Water Resources
City, State, ZIP Code : <u>Ellinwood, Ks. 67526</u>	<u>Sterling, Ks. 67579</u>	Application Number: <u>920-151</u>

3 LOCATE WELL'S LOCATION WITH AN "X" IN SECTION BOX:

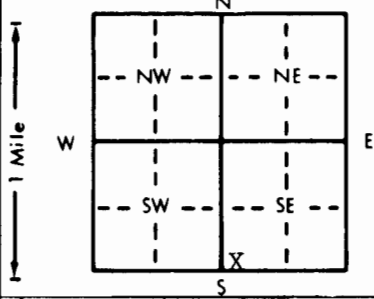

4 DEPTH OF COMPLETED WELL: <u>95</u> ft.	ELEVATION: <u>Unknown</u>
Depth(s) Groundwater Encountered: <u>1.45</u> ft. <u>2</u> ft. <u>3</u> ft.	
WELL'S STATIC WATER LEVEL: <u>45</u> ft. below land surface measured on <u>mo/day/yr</u> <u>4/7/92</u>	
Pump test data: Well water was _____ ft. after _____ hours pumping _____ gpm	
Est. Yield: <u>60</u> gpm: Well water was _____ ft. after _____ hours pumping _____ gpm	
Bore Hole Diameter: <u>8</u> in. to <u>9.5</u> in. and _____ in. to _____ in.	
WELL WATER TO BE USED AS:	
1 Domestic 3 Feedlot 6 Oil field water supply 9 Dewatering 12 Other (Specify below)	
2 Irrigation 4 Industrial 7 Lawn and garden only 10 Monitoring well	
Was a chemical/bacteriological sample submitted to Department? Yes _____ No _____; If yes, mo/day/yr sample was submitted _____	Water Well Disinfected? Yes _____ No _____

5 TYPE OF BLANK CASING USED:	5 Wrought iron	8 Concrete tile	CASING JOINTS: Glued _____ Clamped _____
1 Steel	3 RMP (SR)	6 Asbestos-Cement	9 Other (specify below) _____
<u>2 PVC</u>	4 ABS	7 Fiberglass	Welded _____
Blank casing diameter: <u>5</u> in. to <u>7.5</u> ft., Dia _____ in. to _____ ft., Dia _____ in. to _____ ft.			Threaded _____
Casing height above land surface: <u>12</u> in., weight <u>2.8</u> lbs./ft. Wall thickness or gauge No. <u>Sch. 40</u>			
TYPE OF SCREEN OR PERFORATION MATERIAL:	<u>7 PVC</u>	10 Asbestos-cement	
1 Steel	3 Stainless steel	5 Fiberglass	8 RMP (SR)
2 Brass	4 Galvanized steel	6 Concrete tile	9 ABS
3 Screen or perforation openings are:	5 Gauzed wrapped	<u>8 Saw cut</u>	11 None (open hole)
1 Continuous slot	3 Mill slot	6 Wire wrapped	9 Drilled holes
2 Louvered shutter	4 Key punched	7 Torch cut	10 Other (specify) _____
SCREEN-PERFORATED INTERVALS: From <u>75</u> ft. to <u>95</u> ft., From _____ ft. to _____ ft.			
GRAVEL PACK INTERVALS: From <u>20</u> ft. to <u>95</u> ft., From _____ ft. to _____ ft.			

6 GROUT MATERIAL: <u>1 Neat cement</u>	2 Cement grout	3 Bentonite	4 Other _____
Grout Intervals: From <u>0</u> ft. to <u>20</u> ft., From _____ ft. to _____ ft., From _____ ft. to _____ ft.			
What is the nearest source of possible contamination:	7 Pit privy	10 Livestock pens	14 Abandoned water well
1 Septic tank	4 Lateral lines	11 Fuel storage	15 Oil well/Gas well
2 Sewer lines	5 Cess pool	12 Fertilizer storage	16 Other (specify below)
3 Watertight sewer lines	6 Seepage pit	9 Feedyard	
Direction from well? <u>South</u>		13 Insecticide storage	How many feet? <u>60</u>

FROM	TO	LITHOLOGIC LOG	FROM	TO	PLUGGING INTERVALS
0	70	Clay			
70	95	Sand and gravel			

7 CONTRACTOR'S OR LANDOWNER'S CERTIFICATION: This water well was (1) constructed, (2) reconstructed, or (3) plugged under my jurisdiction and was completed on (mo/day/year) 4/7/92 and this record is true to the best of my knowledge and belief. Kansas Water Well Contractor's License No. 186 This Water Well Record was completed on (mo/day/yr) 5/21/92 under the business name of Kelly's Water Well Service by (signature) [Signature]

INSTRUCTIONS: Use typewriter or ball point pen. PLEASE PRESS FIRMLY and PRINT clearly. Please fill in blanks, underline or circle the correct answers. Send top three copies to Kansas Department of Health and Environment, Bureau of Water, Topeka, Kansas 66620-0001. Telephone: 913-296-5545. Send one to WATER WELL OWNER and retain one for your records.