


1 LOCATION OF WATER WELL: County: Stafford Fraction: SW 1/4 SW 1/4 SE 1/4 Section Number: 11 Township Number: T 21 S Range Number: R 21W

Distance and direction from nearest town or city street address of well if located within city?  
8 S, 5 E of Ellinwood, Kansas

2 WATER WELL OWNER: Eldo McFarland  
RR#, St. Address, Box # : Sterling, Kansas 67579 Board of Agriculture, Division of Water Resources  
City, State, ZIP Code : Application Number: None

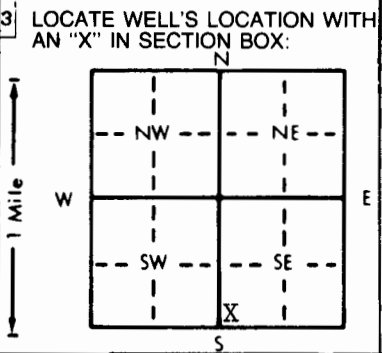

4 DEPTH OF COMPLETED WELL: 50 ft. ELEVATION: Unknown  
Depth(s) Groundwater Encountered 1. 8 ft. 2. 8 ft. 3. 5/21/90 ft.  
WELL'S STATIC WATER LEVEL 8 ft. below land surface measured on mo/day/yr  
Pump test data: Well water was 60 gpm: Well water was 8 ft. after 50 hours pumping 60 gpm  
Est. Yield 60 gpm: Well water was 8 ft. after 50 hours pumping 60 gpm  
Bore Hole Diameter 8 in. to 50 ft., and 8 in. to 50 ft.  
WELL WATER TO BE USED AS:  
5 Public water supply 8 Air conditioning 11 Injection well  
1 Domestic 3 Feedlot 6 Oil field water supply 9 Dewatering 12 Other (Specify below)  
2 Irrigation 4 Industrial 7 Lawn and garden only 10 Monitoring well  
Was a chemical/bacteriological sample submitted to Department? Yes No; If yes, mo/day/yr sample was submitted  
Water Well Disinfected? Yes No

5 TYPE OF BLANK CASING USED:  
1 Steel 3 RMP (SR) 5 Wrought iron 8 Concrete tile CASING JOINTS: Glued Clamped  
2 PVC 4 ABS 6 Asbestos-Cement 9 Other (specify below) Welded  
7 Fiberglass Threaded  
Blank casing diameter 5 in. to 40 ft., Dia 5 in. to 40 ft., Dia 5 in. to 40 ft.  
Casing height above land surface 12 in., weight 2.8 lbs./ft. Wall thickness or gauge No. Sch. 40  
TYPE OF SCREEN OR PERFORATION MATERIAL:  
1 Steel 3 Stainless steel 5 Fiberglass 7 PVC 10 Asbestos-cement  
2 Brass 4 Galvanized steel 6 Concrete tile 8 RMP (SR) 11 Other (specify)  
SCREEN OR PERFORATION OPENINGS ARE:  
1 Continuous slot 3 Mill slot 5 Gauzed wrapped 8 Saw cut 11 None (open hole)  
2 Louvered shutter 4 Key punched 6 Wire wrapped 9 Drilled holes  
3 40 7 Torch cut 10 Other (specify)  
SCREEN-PERFORATED INTERVALS: From 0 ft. to 20 ft., From 0 ft. to 20 ft.  
GRAVEL PACK INTERVALS: From 20 ft. to 50 ft., From 20 ft. to 50 ft.

6 GROUT MATERIAL: 1 Neat cement 2 Cement grout 3 Bentonite 4 Other  
Grout Intervals: From 0 ft. to 20 ft., From 0 ft. to 20 ft.  
What is the nearest source of possible contamination:  
1 Septic tank 4 Lateral lines 7 Pit privy 10 Livestock pens 14 Abandoned water well  
2 Sewer lines 5 Cess pool 8 Sewage lagoon 11 Fuel storage 15 Oil well/Gas well  
3 Watertight sewer lines 6 Seepage pit 9 Feedyard 12 Fertilizer storage 16 Other (specify below)  
In pasture  
Direction from well? How many feet?

FROM	TO	LITHOLOGIC LOG	FROM	TO	PLUGGING INTERVALS
0	20	Sandy clay			
20	50	Sand and gravel			

7 CONTRACTOR'S OR LANDOWNER'S CERTIFICATION: This water well was (1) constructed, (2) reconstructed, or (3) plugged under my jurisdiction and was completed on (mo/day/year) 5/21/90 and this record is true to the best of my knowledge and belief, Kansas  
Water Well Contractor's License No. 186 This Water Well Record was completed on (mo/day/yr) 6/24/90  
under the business name of Kelly's Water Well Service, Inc. by (signature) [Signature]

OFFICE USE ONLY  
T  
R  
E/W  
SEC.  
1/4  
1/4  
1/4