


1 LOCATION OF WATER WELL:		Fraction	Section Number		Township Number		Range Number	
County:	Stafford	E $\frac{1}{2}$ $\frac{1}{4}$ NW $\frac{1}{4}$ SE $\frac{1}{4}$	18		T 21 S		R 11W E/W	

5 E, 8 N of Hudson, Kansas

2	WATER WELL OWNER:	Howard Keller	Sterling Drilling Co.	Rader 3-18
	RR#, St. Address, Box # :	Ellinwood, Ks.	Box 129	Board of Agriculture, Division of Water Resources
	City, State, ZIP Code :	67526	Sterling, Ks. 67579	Application Number: 900270

LOCATE WELL'S LOCATION WITH AN "X" IN SECTION BOX: 4 DEPTH OF COMPLETED WELL: 80 ft. ELEVATION: Unknown

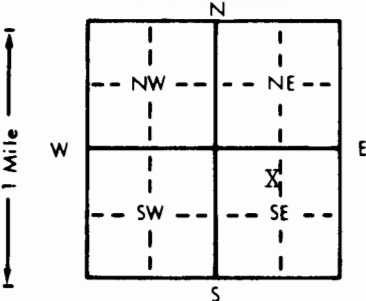

4. DEPTH OF COMPLETED WELL: 80 ft. ELEVATION: Unknown
 Depth(s) Groundwater Encountered 1. 25 ft. 2. ft. 3. ft.
 WELL'S STATIC WATER LEVEL 25 ft. below land surface measured on mo/day/yr 6/21/90

Pump test data: Well water was ft. after hours pumping gpm
 Est. Yield 60 gpm: Well water was ft. after hours pumping gpm
 Bore Hole Diameter . . . 8 . . . in. to 80 . . . ft. and . . . in. to . . . ft.

WELL WATER TO BE USED AS:			
1 Domestic	3 Feedlot	5 Public water supply	8 Air conditioning
2 Irrigation	4 Industrial	6 <u>Oil field water supply</u>	9 Dewatering
		7 Lawn and garden only	10 Monitoring well
			11 Injection well
			12 Other (Specify below)

Was a chemical/bacteriological sample submitted to Department? Yes.....No.....; If yes, mo/day/yr sample was submitted

Water Well Disinfected? Yes No

5	TYPE OF BLANK CASING USED:		5 Wrought iron	8 Concrete tile	CASING JOINTS: <u>Glued</u> Clamped Welded Threaded
	1 Steel	3 RMP (SR)	6 Asbestos-Cement	9 Other (specify below)	
	2 PVC	4 ABS	7 Fiberglass		

Blank casing diameter 5 in. to 60 ft., Dia in. to ft., Dia in. to ft.
Casing height above land surface 12 in., weight 2.8 lbs./ft. Wall thickness or gauge No. Sch. 40

TYPE OF SCREEN OR PERFORATION MATERIAL:			7 <u>PVC</u>	10 Asbestos-cement
1 Steel	3 Stainless steel	5 Fiberglass	8 RMP (SR)	11 Other (specify)
2 Brass	4 Galvanized steel	6 Concrete tile	9 ABS	12 None used (open hole)

SCREEN OR PERFORATION OPENINGS ARE:		5 Gauzed wrapped	8 <u>Saw cut</u>	11 None (open hole)
1 Continuous slot	3 Mill slot	6 Wire wrapped	9 Drilled holes	
2 Louvered shutter	4 Key punched	7 Torch cut	10 Other (specify)	

SCREEN-PERFORATED INTERVALS:	From	60	ft. to	80	ft.	From	ft.	to	ft.
	From		ft. to		ft.	From		ft. to	ft.
GRAVEL PACK INTERVALS:	From	20	ft. to	80	ft.	From		ft. to	ft.
	From		ft. to		ft.	From		ft. to	ft.

9. GROUT MATERIAL: 1 Neat cement 2 Cement grout 3 Bentonite 4 Other

Grout Intervals: From 0 ft. to 20 ft. From ft. to ft. From ft. to ft.

What is the nearest source of possible contamination:

1 Septic tank	4 Lateral lines	7 Pit privy	10 Livestock pens	14 Abandoned water well
2 Sewer lines	5 Cess pool	8 Sewage lagoon	11 Fuel storage	15 <u>Oil well/Gas well</u>
3 Watertight sewer lines	6 Seepage pit	9 Feedyard	12 Fertilizer storage	16 Other (specify below)
			13 Insecticide storage

Direction from well? South How many feet? 60

[illegible]

7] CONTRACTOR'S OR LANDOWNER'S CERTIFICATION: This water well was (1) constructed, (2) reconstructed, or (3) plugged under my jurisdiction and was completed on (mo/day/year) . . . 6/21/90 and this record is true to the best of my knowledge and belief. Kansas Water Well Contractor's License No. . . . 186 This Water Well Record was completed on (mo/day/yr) 7/20/90 under the business name of Kelly's Water Well Service by (signature) [Signature]

INSTRUCTIONS: Use typewriter or ball point pen. **PLEASE PRESS FIRMLY** and **PRINT** clearly. Please fill in blanks, underline or circle the correct answers. Send top three copies to Kansas Department of Health and Environment, Bureau of Water, Topeka, Kansas 66620-7320. Telephone: 913-296-5545. Send one to WATER WELL OWNER and retain one for your records.