


1 LOCATION OF WATER WELL: Fraction NE 1/4 NE 1/4 NW 1/4 Section Number 36 Township Number T 21 S Range Number R 11 E
 County: Stafford

Distance and direction from nearest town or city street address of well if located within city?
N Part of Quivira Refuge

2 WATER WELL OWNER: Quivira Refuge
 RR#, St. Address, Box #: Rt 3 Box 48A
 City, State, ZIP Code: Stafford, KS 67578
 Board of Agriculture, Division of Water Resources
 Application Number:

3 LOCATE WELL'S LOCATION WITH AN "X" IN SECTION BOX:

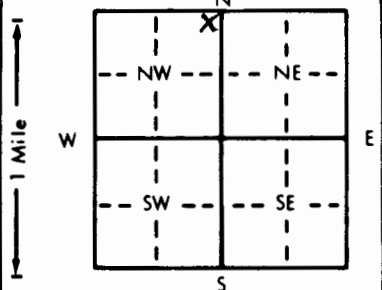

4 DEPTH OF COMPLETED WELL: 22 ft. ELEVATION:
 Depth(s) Groundwater Encountered 1. 13 ft. 2. 10-28-88 ft. 3. 10-28-88 ft.
 WELL'S STATIC WATER LEVEL 13 ft. below land surface measured on mo/day/yr 10-28-88
 Pump test data: Well water was 15 ft. after 1 hours pumping 25 gpm
 Est. Yield 25 gpm: Well water was 15 ft. after 1 hours pumping 25 gpm
 Bore Hole Diameter: 9 in. to 25 ft., and 25 in. to 25 ft.
 WELL WATER TO BE USED AS: 5 Public water supply 8 Air conditioning 11 Injection well
 ① Domestic 3 Feedlot 6 Oil field water supply 9 Dewatering ⑫ Other (Specify below)
 2 Irrigation 4 Industrial 7 Lawn and garden only 10 Monitoring well Stock
 Was a chemical/bacteriological sample submitted to Department? Yes X No X; If yes, mo/day/yr sample was submitted
 Water Well Disinfected? Yes X No

5 TYPE OF BLANK CASING USED: 5 Wrought iron 8 Concrete tile CASING JOINTS: Glued X Clamped
 1 Steel 3 RMP (SR) 6 Asbestos-Cement 9 Other (specify below) Welded
 ④ PVC 4 ABS 7 Fiberglass Threaded
 Blank casing diameter 6 in. to 12 ft., Dia 12 in. to 16 ft., Dia 16 in. to 16 ft.
 Casing height above land surface 12 in., weight 16 lbs./ft. Wall thickness or gauge No. 16
 TYPE OF SCREEN OR PERFORATION MATERIAL: ④ PVC 10 Asbestos-cement
 1 Steel 3 Stainless steel 5 Fiberglass 8 RMP (SR) 11 Other (specify)
 2 Brass 4 Galvanized steel 6 Concrete tile 9 ABS 12 None used (open hole)
 SCREEN OR PERFORATION OPENINGS ARE: 5 Gauzed wrapped ⑧ Saw cut 11 None (open hole)
 1 Continuous slot 3 Mill slot 6 Wire wrapped 9 Drilled holes
 2 Louvered shutter 4 Key punched 7 Torch cut 10 Other (specify)
 SCREEN-PERFORATED INTERVALS: From 12 ft. to 22 ft., From 12 ft. to 12 ft.

6 GROUT MATERIAL: 1 Neat cement 2 Cement grout ③ Bentonite 4 Other
 Grout Intervals: From 0 ft. to 11 ft., From 11 ft. to 11 ft., From 11 ft. to 11 ft.
 What is the nearest source of possible contamination:
 1 Septic tank 4 Lateral lines 7 Pit privy 10 Livestock pens 14 Abandoned water well
 2 Sewer lines 5 Cess pool 8 Sewage lagoon 11 Fuel storage 15 Oil well/Gas well
 3 Watertight sewer lines 6 Seepage pit 9 Feedyard 12 Fertilizer storage ⑬ Other (specify below)
Open field
 Direction from well? How many feet?

FROM	TO	LITHOLOGIC LOG	FROM	TO	PLUGGING INTERVALS
0	5	Dune sand			
5	11	Br clay			
11	22	F-C sand			
22	25	Br clay			
Well No. 3					

7 CONTRACTOR'S OR LANDOWNER'S CERTIFICATION: This water well was ① constructed, (2) reconstructed, or (3) plugged under my jurisdiction and was completed on (mo/day/year) 10-28-88 and this record is true to the best of my knowledge and belief. Kansas Water Well Contractor's License No. 447 This Water Well Record was completed on (mo/day/yr) 6-3-89 under the business name of Miller Drilling by (signature) Eva Miller

INSTRUCTIONS: Use typewriter or ball point pen. PLEASE PRESS FIRMLY and PRINT clearly. Please fill in blanks, underline or circle the correct answers. Send top three copies to Kansas Department of Health and Environment, Bureau of Water Protection, Topeka, Kansas 66620-7320. Telephone: 913-296-5514. Send one to WATER WELL OWNER and retain one for your records.