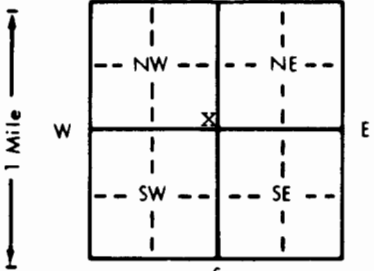


<b>1 LOCATION OF WATER WELL:</b> County: <u>Stafford</u>		Fraction <u>SE</u> $\frac{1}{4}$ <u>SE</u> $\frac{1}{4}$ <u>NW</u> $\frac{1}{4}$		Section Number <u>17</u>	Township Number <u>T 21 S</u>	Range Number <u>R 11W E/W</u>
Distance and direction from nearest town or city street address of well if located within city? <u>7 N, 5 E of Hudson, KS</u>						
<b>2 WATER WELL OWNER:</b> <u>Leona Keeler</u> <u>Sterling Drilling Company</u> <u>Keeler #3-17</u> RR#, St. Address, Box # : <u>311 Pembroke</u> <u>P. O. Box 129</u> Board of Agriculture, Division of Water Resources City, State, ZIP Code : <u>Ellinwood, KS 67526 Sterling, KS 67579</u> Application Number: <u>940300</u>						
<b>3 LOCATE WELL'S LOCATION WITH AN "X" IN SECTION BOX:</b>		<b>4 DEPTH OF COMPLETED WELL</b> <u>66</u> ft. <b>ELEVATION:</b> <u>Unknown</u>				
		Depth(s) Groundwater Encountered <u>1</u> <u>15</u> ft. <u>2</u> ft. <u>3</u> ft.				
		WELL'S STATIC WATER LEVEL <u>15</u> ft. below land surface measured on mo/day/yr <u>8/11/94</u>				
		Pump test data: Well water was _____ ft. after _____ hours pumping _____ gpm				
		Est. Yield <u>60</u> gpm: Well water was _____ ft. after _____ hours pumping _____ gpm				
		Bore Hole Diameter <u>8</u> in. to <u>66</u> ft., and _____ in. to _____ ft.				
		<b>WELL WATER TO BE USED AS:</b> <u>5</u> Public water supply <u>8</u> Air conditioning <u>11</u> Injection well				
		<u>1</u> Domestic <u>3</u> Feedlot <u>6</u> Oil field water supply <u>9</u> Dewatering <u>12</u> Other (Specify below)				
		<u>2</u> Irrigation <u>4</u> Industrial <u>7</u> Lawn and garden only <u>10</u> Monitoring well				
		Was a chemical/bacteriological sample submitted to Department? Yes _____ No <u>XX</u> ; If yes, mo/day/yr sample was submitted _____				
		Water Well Disinfected? Yes _____ No <u>XX</u>				
<b>5 TYPE OF BLANK CASING USED:</b>						
<u>1</u> Steel <u>3</u> RMP (SR)		<u>5</u> Wrought iron		<u>8</u> Concrete tile		CASING JOINTS: <u>Glued XX</u> <u>Clamped</u>
<u>2</u> PVC <u>4</u> ABS		<u>6</u> Asbestos-Cement		<u>9</u> Other (specify below)		<u>Welded</u>
		<u>7</u> Fiberglass				<u>Threaded</u>
Blank casing diameter <u>5</u> in. to <u>46</u> ft., Dia _____ in. to _____ ft., Dia _____ in. to _____ ft.						
Casing height above land surface <u>12</u> in., weight <u>2.8</u> lbs./ft. Wall thickness or gauge No. <u>Sch. 40</u>						
<b>TYPE OF SCREEN OR PERFORATION MATERIAL:</b>						
<u>1</u> Steel <u>3</u> Stainless steel		<u>5</u> Fiberglass		<u>7</u> PVC		<u>10</u> Asbestos-cement
<u>2</u> Brass <u>4</u> Galvanized steel		<u>6</u> Concrete tile		<u>8</u> RMP (SR)		<u>11</u> Other (specify)
				<u>9</u> ABS		<u>12</u> None used (open hole)
<b>SCREEN OR PERFORATION OPENINGS ARE:</b>						
<u>1</u> Continuous slot <u>3</u> Mill slot		<u>5</u> Gauzed wrapped		<u>8</u> Saw cut		<u>11</u> None (open hole)
<u>2</u> Louvered shutter <u>4</u> Key punched		<u>6</u> Wire wrapped		<u>9</u> Drilled holes		
		<u>7</u> Torch cut		<u>10</u> Other (specify)		
<b>SCREEN-PERFORATED INTERVALS:</b> From <u>46</u> ft. to <u>66</u> ft., From _____ ft. to _____ ft.						
From _____ ft. to _____ ft., From _____ ft. to _____ ft.						
<b>GRAVEL PACK INTERVALS:</b> From <u>20</u> ft. to <u>66</u> ft., From _____ ft. to _____ ft.						
From _____ ft. to _____ ft., From _____ ft. to _____ ft.						
<b>6 GROUT MATERIAL:</b> <u>1</u> Neat cement <u>2</u> Cement grout <u>3</u> Bentonite <u>4</u> Other _____						
Grout Intervals: From <u>0</u> ft. to <u>20</u> ft., From _____ ft. to _____ ft., From _____ ft. to _____ ft.						
What is the nearest source of possible contamination:						
<u>1</u> Septic tank <u>4</u> Lateral lines		<u>7</u> Pit privy		<u>10</u> Livestock pens		<u>14</u> Abandoned water well
<u>2</u> Sewer lines <u>5</u> Cess pool		<u>8</u> Sewage lagoon		<u>11</u> Fuel storage		<u>15</u> Oil well/Gas well
<u>3</u> Watertight sewer lines <u>6</u> Seepage pit		<u>9</u> Feedyard		<u>12</u> Fertilizer storage		<u>16</u> Other (specify below)
				<u>13</u> Insecticide storage		
Direction from well? <u>South</u>				How many feet? <u>60</u>		
FROM	TO	LITHOLOGIC LOG		FROM	TO	PLUGGING INTERVALS
				<u>66</u>	<u>15</u>	<u>SAND AND GRAVEL</u>
				<u>15</u>	<u>3</u>	<u>BENTONITE</u>
				<u>3</u>	<u>0</u>	<u>TOP SOIL</u>
<b>7 CONTRACTOR'S OR LANDOWNER'S CERTIFICATION:</b> This water well was (1) constructed, (2) reconstructed, or (3) plugged under my jurisdiction and was completed on (mo/day/year) <u>October 28, 1994</u> and this record is true to the best of my knowledge and belief. Kansas Water Well Contractor's License No. <u>151</u> This Water Well Record was completed on (mo/day/yr) <u>December 8, 1994</u> under the business name of <u>STERLING DRILLING COMPANY</u> by (signature) <u>Richard L. Mead</u>						
INSTRUCTIONS: Use typewriter or ball point pen. PLEASE PRESS FIRMLY and PRINT clearly. Please fill in blanks, underline or circle the correct answers. Send top three copies to Kansas Department of Health and Environment, Bureau of Water, Topeka, Kansas 66620-0001. Telephone: 913-296-5545. Send one to WATER WELL OWNER and retain one for your records.						