


1 LOCATION OF WATER WELL:		Fraction				Section Number		Township Number		Range Number		
County:	Stafford	SW	1/4	SW	1/4	NE	1/4	24	T 21	S	R 12w	E/W

Distance and direction from nearest town or city street address of well if located within city?

7N. 3E of Hudson, Ks.

2) WATER WELL OWNER: Fern Wilson		L. D. Drilling, Inc.	Wilson 1-A
RR#, St. Address, Box # : 7927 E. Neville		RR 1, Box 183 B	Board of Agriculture, Division of Water Resources
City, State, ZIP Code : Mesa, Arizona, 85208		Great Bend, Ks. 67530	Application Number: 20000205

3 LOCATE WELL'S LOCATION WITH AN "X" IN SECTION BOX:	4 DEPTH OF COMPLETED WELL. 111 ft. ELEVATION: unknown
	Depth(s) Groundwater Encountered 1. 30 ft. 2. ft. 3. ft.

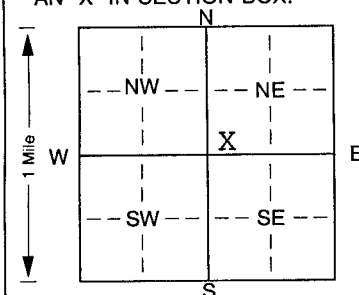

4 DEPTH OF COMPLETED WELL.....111.....ft. ELEVATION: unknown.....
Depth(s) Groundwater Encountered 1.....30.....ft. 2.....ft. 3.....ft.
WELL'S STATIC WATER LEVEL.....30.....ft. below land surface measured on mo/day/yr 10/31/00.....

Pump test data: Well water was ft. after hours pumping gpm
 Est. Yield .. 60 gpm: Well water was ft. after hours pumping gpm
 Bore Hole Diameter... 8 in. to 111 ft., and in. to ft.
 WELL WATER TO BE USED AS: 5 Public water supply 8 Air conditioning 11 Injection well
 1 Domestic 3 Feedlot 6 Oil field water supply 9 Dewatering 12 Other (Specify below)
 2 Irrigation 4 Industrial 7 Domestic (lawn & garden) 10 Monitoring well

Was a chemical/bacteriological sample submitted to Department? Yes. No ; If yes, mo/day/yr sample was submitted _____
 Water Well Disinfected? Yes _____ No _____

5	TYPE OF BLANK CASING USED:		5 Wrought iron	8 Concrete tile	CASING JOINTS: <u>Glued</u> <u>Clamped</u>
	1 Steel	3 RMP (SR)	6 Asbestos-Cement	9 Other (specify below)	Welded
	2 PVC	4 ABS	7 Fiberglass	Threaded

Blank casing diameter . . . 5 . . . in. to . . . 91 . . . ft., Dia . . . in. to . . . ft., Dia . . . in. to . . . ft.
Casing height above land surface. . . 12 . . . in., weight . . . 2.8 . . . lbs./ft. Wall thickness or gauge No. Sch. 40

TYPE OF SCREEN OR PERFORATION MATERIAL:			7 <u>PVC</u>	10 Asbestos-cement
1 Steel	3 Stainless steel	5 Fiberglass	8 RMP (SR)	11 Other (specify)
2 Brass	4 Galvanized steel	6 Concrete tile	9 ABS	12 None used (open hole)

SCREEN OR PERFORATION OPENINGS ARE:

1 Continuous slot	3 Mill slot	5 Gauzed wrapped	8 Saw cut	11 None (open hole)
2 Louvered shutter	4 Key punched	6 Wire wrapped	9 Drilled holes	
		7 Torch cut	10 Other (specify)	ft.

SCREEN-PERFORATED INTERVALS:	From <u>91</u>	ft. to <u>111</u>	ft., From	ft. to	ft.
	From	ft. to	ft., From	ft. to	ft.
GRAVEL PACK INTERVALS:	From <u>21</u>	ft. to <u>111</u>	ft., From	ft. to	ft.
	From	ft. to	ft., From	ft. to	ft.

6	GROUT MATERIAL:	1 Neat cement	2 Cement grout	3 <u>Bentonite</u>	4 Other
	Grout Intervals:	From 0	ft. to 21	ft. From	ft. to

What is the nearest source of possible contamination:

1 Septic tank	4 Lateral lines	7 Pit privy	10 Livestock pens	14 Abandoned water well
2 Sewer lines	5 Cess pool	8 Sewage lagoon	11 Fuel storage	15 <u>Oil well/Gas well</u>
3 Watertight sewer lines	6 Seepage pit	9 Feedyard	12 Fertilizer storage	16 Other (specify below)
			13 Insecticide storage

Direction from well? South

How many feet? 100

[illegible]

7 CONTRACTOR'S OR LANDOWNER'S CERTIFICATION: This water well was (1) constructed, (2) reconstructed, or (3) plugged under my jurisdiction and was completed on (mo/day/year) 10/31/00 and this record is true to the best of my knowledge and belief. Kansas Water Well Contractor's Licence No. 186 This Water Well Record was completed on (mo/day/yr) 11/01/00 under the business name of Kelly's Water Well Service, Inc. by (signature) [Signature]