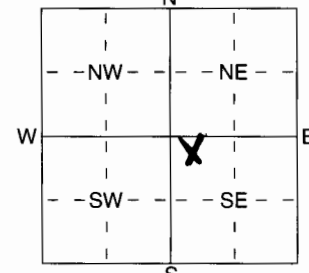


1 LOCATION OF WATER WELL: County: Stafford	Fraction NW 1/4 NW 1/4 SE 1/4	Section Number 19	Township Number T 21 S	Range Number R 12 E/W
--	---	-----------------------------	----------------------------------	--

Distance and direction from nearest town or city street address of well if located within city?
6 miles East & 2.5 miles North of Seward, Ks.

2 WATER WELL OWNER: **Barbara Hall Walls**
 RR#, St. Address, Box # : **Po Box 1675**
 City, State, ZIP Code : **Great Bend, Ks. 67530**
 Board of Agriculture, Division of Water Resources
 Application Number:

3 LOCATE WELL'S LOCATION WITH AN "X" IN SECTION BOX: 	4 DEPTH OF COMPLETED WELL 84 ft. ELEVATION: Depth(s) Groundwater Encountered 1 ft. 2 ft. 3 ft. WELL'S STATIC WATER LEVEL 1.8 ft. below land surface measured on mo/day/yr 3/27/06 Pump test data: Well water was ft. after hours pumping gpm Est. Yield 50 gpm: Well water was ft. after hours pumping gpm WELL WATER TO BE USED AS: 1 Domestic 3 Feedlot 6 Oil field water supply 9 Dewatering 12 Other (Specify below) 2 Irrigation 4 Industrial 7 Domestic (lawn & garden) <input checked="" type="checkbox"/> <u>Monitoring well</u>
--	---

Was a chemical/bacteriological sample submitted to Department? Yes No ; If yes, mo/day/yr sample was submitted
 Water Well Disinfected? Yes No

5 TYPE OF BLANK CASING USED:
 1 Steel 3 RMP (SR) 5 Wrought iron 8 Concrete tile CASING JOINTS: Glued Clamped
 PVC 4 ABS 6 Asbestos-Cement 9 Other (specify below) Welded
 7 Fiberglass Threaded
 Blank casing diameter **2** in. to **7.4** ft., Dia in. to ft., Dia in. to ft.
 Casing height above land surface **1.2** in., weight **.703** lbs./ft. Wall thickness or guage No. **.154**
 TYPE OF SCREEN OR PERFORATION MATERIAL:
 1 Steel 3 Stainless Steel 5 Fiberglass 8 RMP (SR) 10 Asbestos-Cement
 2 Brass 4 Galvanized Steel 6 Concrete tile 9 ABS 11 Other (Specify)
 12 None used (open hole)
 SCREEN OR PERFORATION OPENINGS ARE:
 1 Continuous slot Mill slot 5 Guazed wrapped 8 Saw cut 11 None (open hole)
 2 Louvered shutter 4 Key punched 6 Wire wrapped 9 Drilled holes
 7 Torch cut 10 Other (specify) ft.
 SCREEN-PERFORATED INTERVALS: From **74** ft. to **84** ft., From ft. to ft.
 GRAVEL PACK INTERVALS: From **20** ft. to **84** ft., From ft. to ft.

6 GROUT MATERIAL: 1 Neat cement 2 Cement grout Bentonite 4 Other
 Grout Intervals: From **0** ft. to **20** ft., From ft. to ft., From ft. to ft.
 What is the nearest source of possible contamination:
 1 Septic tank 4 Lateral lines 7 Pit privy 10 Livestock pens 14 Abandoned water well
 2 Sewer lines 5 Cess pool 8 Sewage lagoon 11 Fuel storage Oil well/Gas well
 3 Watertight sewer lines 6 Seepage pit 9 Feedyard 12 Fertilizer storage 16 Other (specify below)
 13 Insecticide storage
 Direction from well? **West** How many feet? **500 ft.**

FROM	TO	LITHOLOGIC LOG	FROM	TO	PLUGGING INTERVALS
0	2	Topsoil			
2	18	Clay, tan			
18	27	Sand, fine			
27	41	Clay, gray			
41	48	Sand, fine			
48	60	Clay, gray			
60	84	Sand, fine to medium			
84	86	Clay, gray			

7 CONTRACTOR'S OR LANDOWNER'S CERTIFICATION: This water well was (1) constructed, (2) reconstructed, or (3) plugged under my jurisdiction and was completed on (mo/day/year) **3/28/06** and this record is true to the best of my knowledge and belief. Kansas Water Well Contractor's Licence No **138**. This Water Well Record was completed on (mo/day/yr) **4/3/06** under the business name of **Peterson Irrigation, Inc.** by (signature) *Mike Peterson*