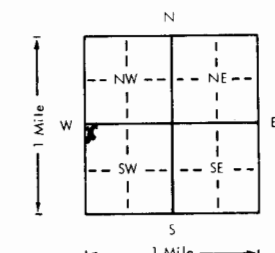


1 LOCATION OF WATER WELL		Fraction	Section Number	Township Number	Range Number		
County: <b>Stafford</b>		NW 1/4 SW 1/4 SW 1/4	6	T 21 S	R 12 EW		
Distance and direction from nearest town or city? <b>11 mi N, 2 mi W of Hudson</b>			Street address of well if located within city?				
2 WATER WELL OWNER: <b>Kansas Geological Survey/Groundwater Management District #5</b>							
RR#, St. Address, Box # :			Board of Agriculture, Division of Water Resources				
City, State, ZIP Code : <b>St. John, Kansas 67576</b>			Application Number:				
3 DEPTH OF COMPLETED WELL... <b>211</b> ... ft. Bore Hole Diameter... <b>9 7/8</b> n. to <b>211</b> ... ft., and ... in. to ... ft.							
Well Water to be used as:							
1 Domestic 3 Feedlot		5 Public water supply		8 Air conditioning			
2 Irrigation 4 Industrial		6 Oil field water supply		9 Dewatering			
		7 Lawn and garden only		10 Observation well			
				11 Injection well			
				12 Other (Specify below)			
				<b>Research</b>			
Well's static water level... <b>26.76</b> ... ft. below land surface measured on <b>Jan.</b> month <b>6</b> day <b>83</b> year							
Pump Test Data : Well water was... ft. after... hours pumping... gpm							
Est. Yield gpm: Well water was... ft. after... hours pumping... gpm							
4 TYPE OF BLANK CASING USED:							
1 Steel		3 RMP (SR)		5 Wrought iron			
2 PVC		4 ABS		6 Asbestos-Cement			
				7 Fiberglass			
				8 Concrete tile			
				9 Other (specify below)			
				Casing Joints <b>Glued</b> Clamped			
				Welded			
				Threaded			
Blank casing dia... <b>5</b> ... in. to <b>206</b> ... ft., Dia... in. to... ft., Dia... in. to... ft.							
Casing height above land surface... in., weight... lbs./ft. Wall thickness or gauge No... <b>Schd. #2040</b>							
TYPE OF SCREEN OR PERFORATION MATERIAL:							
1 Steel		3 Stainless steel		5 Fiberglass			
2 Brass		4 Galvanized steel		6 Concrete tile			
				7 RMP (SR)			
				8 ABS			
				10 Asbestos-cement			
				11 Other (specify)			
				12 None used (open hole)			
Screen or Perforation Openings Are:							
1 Continuous slot		3 Mill slot		5 Gauzed wrapped			
2 Louvered shutter		4 Key punched		6 Wire wrapped			
				7 Torch cut			
				8 Saw cut			
				11 None (open hole)			
Screen-Perforation Dia... <b>5</b> ... in. to <b>170</b> ... ft., Dia... in. to... ft., Dia... in. to... ft.							
Screen-Perforated Intervals: From... <b>206</b> ... ft. to <b>211</b> ... ft., From... ft. to... ft., From... ft. to... ft.							
Gravel Pack Intervals: From... <b>197</b> ... ft. to <b>211</b> ... ft., From... ft. to... ft., From... ft. to... ft.							
5 GROUT MATERIAL:							
1 Neat cement		2 Cement grout		3 Bentonite			
4 Other							
Grouted Intervals: From... <b>197</b> ... ft. to <b>170</b> ... ft., From... <b>0</b> ... ft. to <b>10</b> ... ft., From... ft. to... ft.							
What is the nearest source of possible contamination: <b>not known</b>							
1 Septic tank		4 Cess pool		7 Sewage lagoon			
2 Sewer lines		5 Seepage pit		8 Feed yard			
3 Lateral lines		6 Pit privy		9 Livestock pens			
				10 Fuel storage			
				11 Fertilizer storage			
				12 Insecticide storage			
				13 Watertight sewer lines			
				14 Abandoned water well			
				15 Oil well/Gas well			
				16 Other (specify below)			
Direction from well... How many feet... ? Water Well Disinfected? Yes... <b>No</b>							
Was a chemical/bacteriological sample submitted to Department? Yes... <b>No</b> If yes, date sample was submitted... month... day... year: Pump installed? Yes... <b>No</b>							
If Yes: Pump Manufacturer's name... Model No... HP... Volts...							
Depth of Pump Intake... ft. Pumps Capacity rated at... gal./min.							
Type of pump: 1 Submersible 2 Turbine 3 Jet 4 Centrifugal 5 Reciprocating 6 Other							
6 CONTRACTOR'S OR LANDOWNER'S CERTIFICATION: This water well was <b>(1)</b> constructed, (2) reconstructed, or (3) plugged under my jurisdiction and was completed on... <b>August</b> ... month... <b>4</b> ... day... <b>81</b> ... year.							
and this record is true to the best of my knowledge and belief. Kansas Water Well Contractor's License No. <b>1</b>							
This Water Well Record was completed on... <b>1</b> ... month... <b>27</b> ... day... <b>83</b> ... year under the business name of <b>Patrick M Cobb</b> by (signature)							
7 LOCATE WELL'S LOCATION WITH AN "X" IN SECTION BOX:		FROM	TO	LITHOLOGIC LOG	FROM	TO	LITHOLOGIC LOG
							
ELEVATION: <b>1855</b>							
Depth(s) Groundwater Encountered 1... ft. 2... ft. 3... ft. 4... ft. (Use a second sheet if needed)							
INSTRUCTIONS: Use typewriter or ball point pen, please press firmly and PRINT clearly. Please fill in blanks, underline or circle the correct answers. Send top three copies to Kansas Department of Health and Environment, Division of Environment, Water Well Contractors, Topeka, KS 66620. Send one to WATER WELL OWNER and retain one for your records.							

BIG BEND GMD#5-KGS  
WATER QUALITY  
OBSERVATION WELL  
NETWORK

SITE NUMBER : 22 (KP4)  
SITE LOCATION: NW SW SW


LEGAL LOCATION: 6-21-12W  
COUNTY : STAFFORD

## WELL LOG

[illegible]

SITE NUMBER : 22 (KP4)  
SITE LOCATION : NW SW SW  
LEGAL LOCATION: SEC6 T21S R12W  
COUNTY : STAFFORD

LANDOWNER: FRANCIS CAREY  
ADDRESS : 112 East 2nd  
ELLINWOOD, KANSAS 67526  
PHONE NO.: 316-564-2567

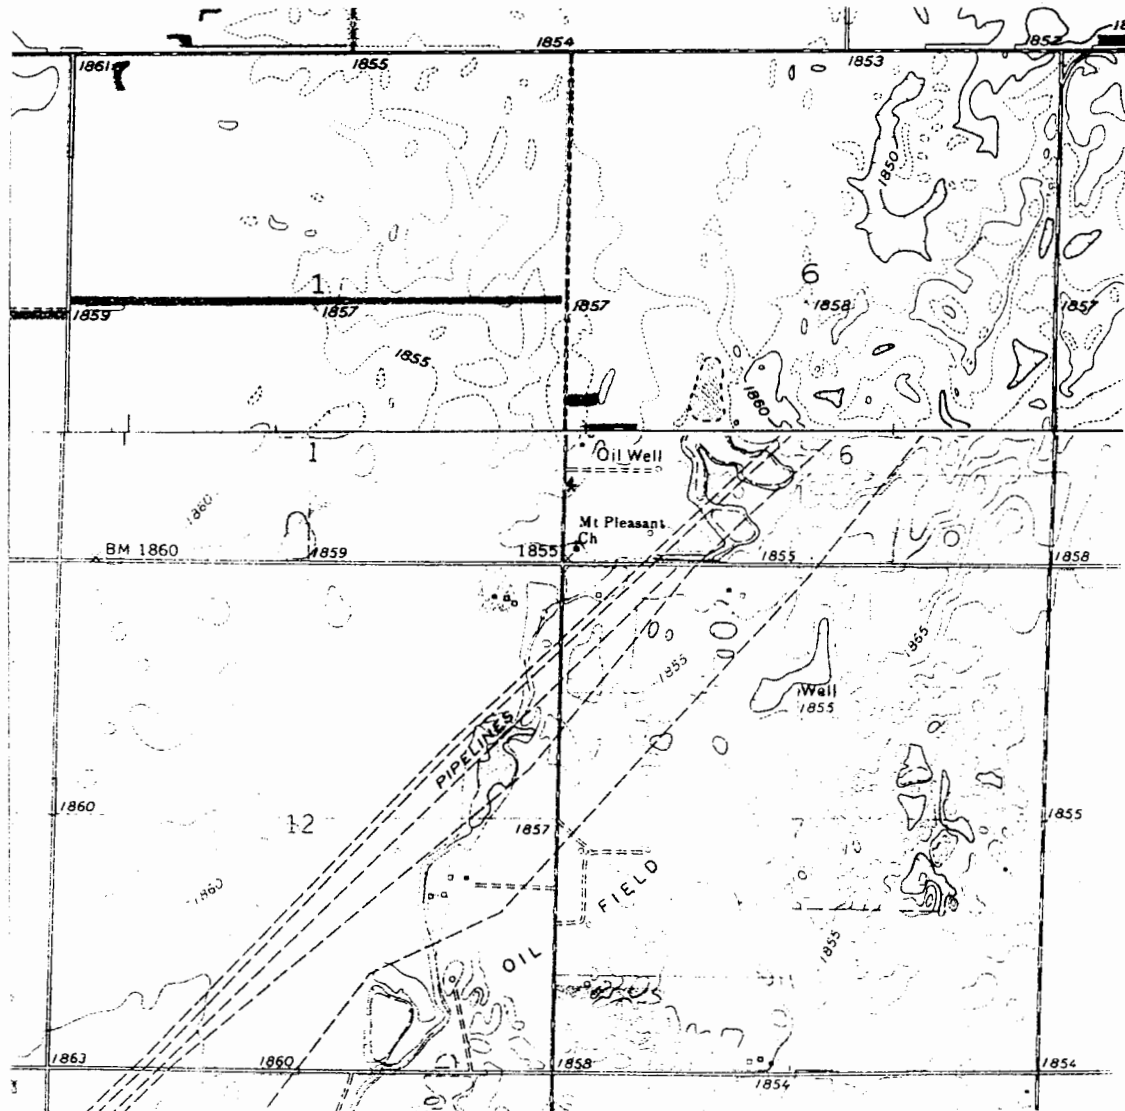

WELL LOCATION \*