

1 LOCATION OF WATER WELL	Fraction	Section Number	Township Number	Range Number
County: Stafford	NW 1/4 SW 1/4 SW 1/4	6	T 21 S	R 12 EW

Distance and direction from nearest town or city? **11 mi N, 2 mi W of Hudson**

Street address of well if located within city?

2 WATER WELL OWNER: **Kansas Geological Survey/Groundwater Management District #5**

RR#, St. Address, Box # : **Board of Agriculture, Division of Water Resources**

City, State, ZIP Code : **St. John, Kansas 67576** Application Number:

3 DEPTH OF COMPLETED WELL: **45** ft. Bore Hole Diameter: **9 7/8** in. to ft., and in. to ft.

Well Water to be used as:

5 Public water supply	8 Air conditioning	11 Injection well		
1 Domestic	3 Feedlot	6 Oil field water supply	9 Dewatering	12 Other (Specify below)
2 Irrigation	4 Industrial	7 Lawn and garden only	10 Observation well	Research

Well's static water level: **20.75** ft. below land surface measured on **Jan.** month **6** day **83** year

Pump Test Data : Well water was ft. after hours pumping. gpm

Est. Yield gpm: Well water was ft. after hours pumping gpm

4 TYPE OF BLANK CASING USED:

5 Wrought iron	8 Concrete tile	Casing Joints: Glued	Clamped	
1 Steel	3 RMP (SR)	6 Asbestos-Cement	9 Other (specify below)	Welded
2 PVC	4 ABS	7 Fiberglass		Threaded

Blank casing dia: **5** in. to **35** ft., Dia in. to ft., Dia in. to ft.

Casing height above land surface in., weight lbs./ft. Wall thickness or gauge No **Schd #40**

TYPE OF SCREEN OR PERFORATION MATERIAL:

1 Steel	3 Stainless steel	5 Fiberglass	8 RMP (SR)	10 Asbestos-cement
2 Brass	4 Galvanized steel	6 Concrete tile	9 ABS	11 Other (specify)
				12 None used (open hole)

Screen or Perforation Openings Are:

5 Gauzed wrapped	8 Saw cut	11 None (open hole)	
1 Continuous slot	3 Mill slot	6 Wire wrapped	9 Drilled holes
2 Louvered shutter	4 Key punched	7 Torch cut	10 Other (specify)

Screen-Perforation Dia: **5** in. to ft., Dia in. to ft., Dia in. to ft.

Screen-Perforated Intervals: From **35** ft. to **45** ft., From ft. to ft., From ft. to ft.

Gravel Pack Intervals: From **26** ft. to **45** ft., From ft. to ft., From ft. to ft.

5 GROUT MATERIAL: **1 Neat cement** 2 Cement grout 3 Bentonite 4 Other

Grouted Intervals: From **0** ft. to **10** ft., From ft. to ft., From ft. to ft.

What is the nearest source of possible contamination: **not known**

1 Septic tank	4 Cess pool	7 Sewage lagoon	10 Fuel storage	14 Abandoned water well
2 Sewer lines	5 Seepage pit	8 Feed yard	11 Fertilizer storage	15 Oil well/Gas well
3 Lateral lines	6 Pit privy	9 Livestock pens	12 Insecticide storage	16 Other (specify below)
			13 Watertight sewer lines	

Direction from well How many feet ? Water Well Disinfected? Yes **No**

Was a chemical/bacteriological sample submitted to Department? Yes **No** If yes, date sample was submitted month day year: Pump Installed? Yes **No**

If Yes: Pump Manufacturer's name Model No. HP Volts

Depth of Pump Intake ft. Pumps Capacity rated at gal./min.

Type of pump: 1 Submersible 2 Turbine 3 Jet 4 Centrifugal 5 Reciprocating 6 Other

6 CONTRACTOR'S OR LANDOWNER'S CERTIFICATION: This water well was **(1)** constructed, (2) reconstructed, or (3) plugged under my jurisdiction and was completed on **July** month **29** day **81** year

and this record is true to the best of my knowledge and belief. Kansas Water Well Contractor's License No.

This Water Well Record was completed on **1** month **27** day **83** year under the business name of **Patricia M. Cell** by (signature)

7 LOCATE WELL'S LOCATION WITH AN "X" IN SECTION BOX:	FROM		TO		LITHOLOGIC LOG	
	FROM	TO	FROM	TO	FROM	TO

ELEVATION: **1855**


Depth(s) Groundwater Encountered 1. ft. 2. ft. 3. ft. 4. ft. (Use a second sheet if needed)

INSTRUCTIONS: Use typewriter or ball point pen, please press firmly and PRINT clearly. Please fill in blanks, underline (or circle the correct answers. Send top three copies to Kansas Department of Health and Environment, Division of Environment, Water Well Contractors, Topeka, KS 66620. Send one to WATER WELL OWNER and retain one for your records.

OFFICE USE ONLY
T 21
R 12
EW W SEC 6
NW 1/4 SW 1/4 SW 1/4

SITE NUMBER : 22 (KP4)
SITE LOCATION : NW SW SW
LEGAL LOCATION: SEC6 T21S R12W
COUNTY : STAFFORD

LANDOWNER: FRANCIS CAREY
ADDRESS : 112 East 2nd
ELLINWOOD, KANSAS 67526
PHONE NO.: 316-564-2567

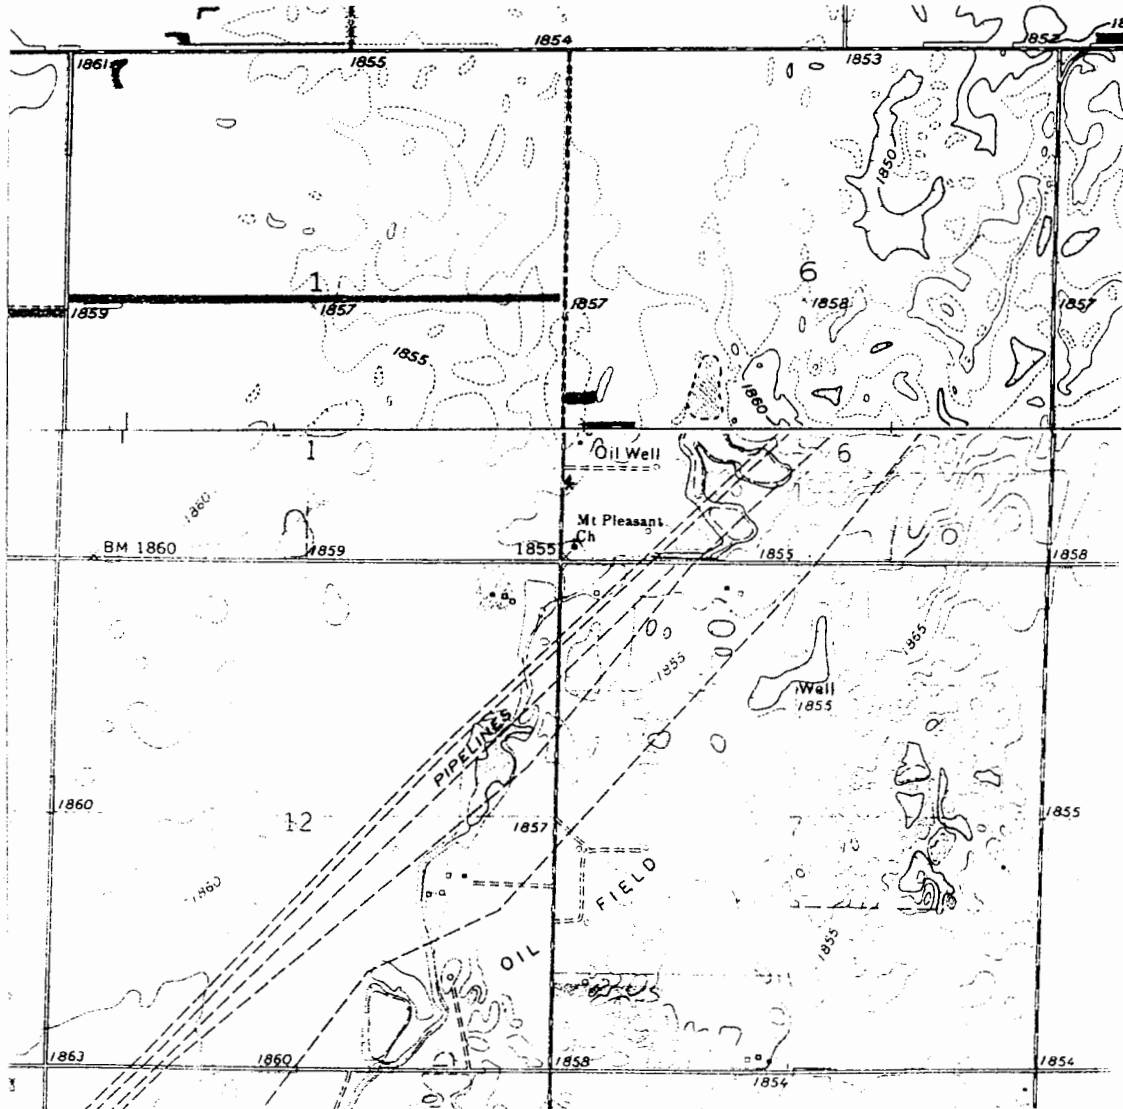

WELL LOCATION *