

1 LOCATION OF WATER WELL	Fraction	Section Number	Township Number	Range Number
County: Stafford	SW 1/4 SW 1/4 SW 1/4	31	T 21 S	R 12 EW

Distance and direction from nearest town or city? **5 mi N, 2 mi W Hudson, Kansas**

Street address of well if located within city?

2 WATER WELL OWNER: **Kansas Geological Survey/Groundwater Management District #5**

RR#, St. Address, Box # : _____ Board of Agriculture, Division of Water Resources

City, State, ZIP Code : **St. John, Kansas 67576** Application Number: _____

3 DEPTH OF COMPLETED WELL... **203** ft. Bore Hole Diameter... **9 7/8** in. to _____ ft., and _____ in. to _____ ft.

Well Water to be used as:

5 Public water supply	8 Air conditioning	11 Injection well
1 Domestic	9 Dewatering	12 Other (Specify below)
3 Feedlot	<u>10 Observation well</u>	Research
6 Oil field water supply		
2 Irrigation		
4 Industrial		
7 Lawn and garden only		

Well's static water level... **18.3** ft. below land surface measured on **Jan.** month **6** day **83** year

Pump Test Data : Well water was _____ ft. after _____ hours pumping _____ gpm

Est. Yield gpm: Well water was _____ ft. after _____ hours pumping _____ gpm

4 TYPE OF BLANK CASING USED:

5 Wrought iron	8 Concrete tile	Casing Joints Glued	Clamped
1 Steel	9 Other (specify below)	Welded	
<u>2 PVC</u>		Threaded	
3 RMP (SR)			
4 ABS			
6 Asbestos-Cement			
7 Fiberglass			

Blank casing dia **5** in. to **198** ft. Dia _____ in. to _____ ft. Dia _____ in. to _____ ft.

Casing height above land surface **24** in., weight _____ lbs./ft. Wall thickness or gauge No **Schd #40**

TYPE OF SCREEN OR PERFORATION MATERIAL:

7 PVC	10 Asbestos-cement
1 Steel	11 Other (specify)
2 Brass	12 None used (open hole)
3 Stainless steel	
4 Galvanized steel	
5 Fiberglass	
6 Concrete tile	
8 RMP (SR)	
9 ABS	

Screen or Perforation Openings Are:

3 Mill slot	8 Saw cut	11 None (open hole)
1 Continuous slot	9 Drilled holes	
2 Louvered shutter	10 Other (specify)	
4 Key punched		
5 Gauzed wrapped		
6 Wire wrapped		
7 Torch cut		

Screen-Perforation Dia **5** in. to **203** ft. Dia _____ in. to _____ ft. Dia _____ in. to _____ ft.

Screen-Perforated Intervals: From **198** ft. to **203** ft. From _____ ft. to _____ ft. From _____ ft. to _____ ft.

Gravel Pack Intervals: From **195** ft. to **203** ft. From _____ ft. to _____ ft. From _____ ft. to _____ ft.

5 GROUT MATERIAL: 1 Neat cement 2 Cement grout 3 Bentonite 4 Other

Grouted Intervals: From **195** ft. to **45** ft. From **0** ft. to **10** ft. From _____ ft. to _____ ft.

What is the nearest source of possible contamination:

1 Septic tank	4 Cess pool	7 Sewage lagoon	10 Fuel storage	14 Abandoned water well
2 Sewer lines	5 Seepage pit	8 Feed yard	11 Fertilizer storage	15 Oil well/Gas well
3 Lateral lines	6 Pit privy	9 Livestock pens	12 Insecticide storage	16 Other (specify below)
			13 Watertight sewer lines	

Direction from well _____ How many feet _____ ? Water Well Disinfected? Yes **No**

Was a chemical/bacteriological sample submitted to Department? Yes **No** If yes, date sample was submitted _____ month _____ day _____ year: Pump Installed? Yes **No**

If Yes: Pump Manufacturer's name _____ Model No. _____ HP _____ Volts _____

Depth of Pump Intake _____ ft. Pumps Capacity rated at _____ gal./min.

Type of pump: 1 Submersible 2 Turbine 3 Jet 4 Centrifugal 5 Reciprocating 6 Other

6 CONTRACTOR'S OR LANDOWNER'S CERTIFICATION: This water well was (1) constructed, (2) reconstructed, or (3) plugged under my jurisdiction and was completed on **9** month **26** day **81** year.

and this record is true to the best of my knowledge and belief. Kansas Water Well Contractor's License No. _____

This Water Well Record was completed on **1** month **27** day **83** year under the business name of _____ by (signature) *Patrick M. Cobb*

7 LOCATE WELL'S LOCATION WITH AN "X" IN SECTION BOX:

FROM	TO	LITHOLOGIC LOG	FROM	TO	LITHOLOGIC LOG


ELEVATION: **1871**

Depth(s) Groundwater Encountered 1. _____ ft. 2. _____ ft. 3. _____ ft. 4. _____ ft. (Use a second sheet if needed)

INSTRUCTIONS: Use typewriter or ball point pen, please press firmly and PRINT clearly. Please fill in blanks, underline or circle the correct answers. Send top three copies to Kansas Department of Health and Environment, Division of Environment, Water Well Contractors, Topeka, KS 66620. Send one to WATER WELL OWNER and retain one for your records.

SITE NUMBER : 16 (KPI)
SITE LOCATION : SW SW SW
LEGAL LOCATION: SEC31 T21S R12W
COUNTY : STAFFORD

LANDOWNER: GERALD FISCHER
ADDRESS : RURAL ROUTE
SEWARD, KANSAS 67577
PHONE NO.: 316-458-2623

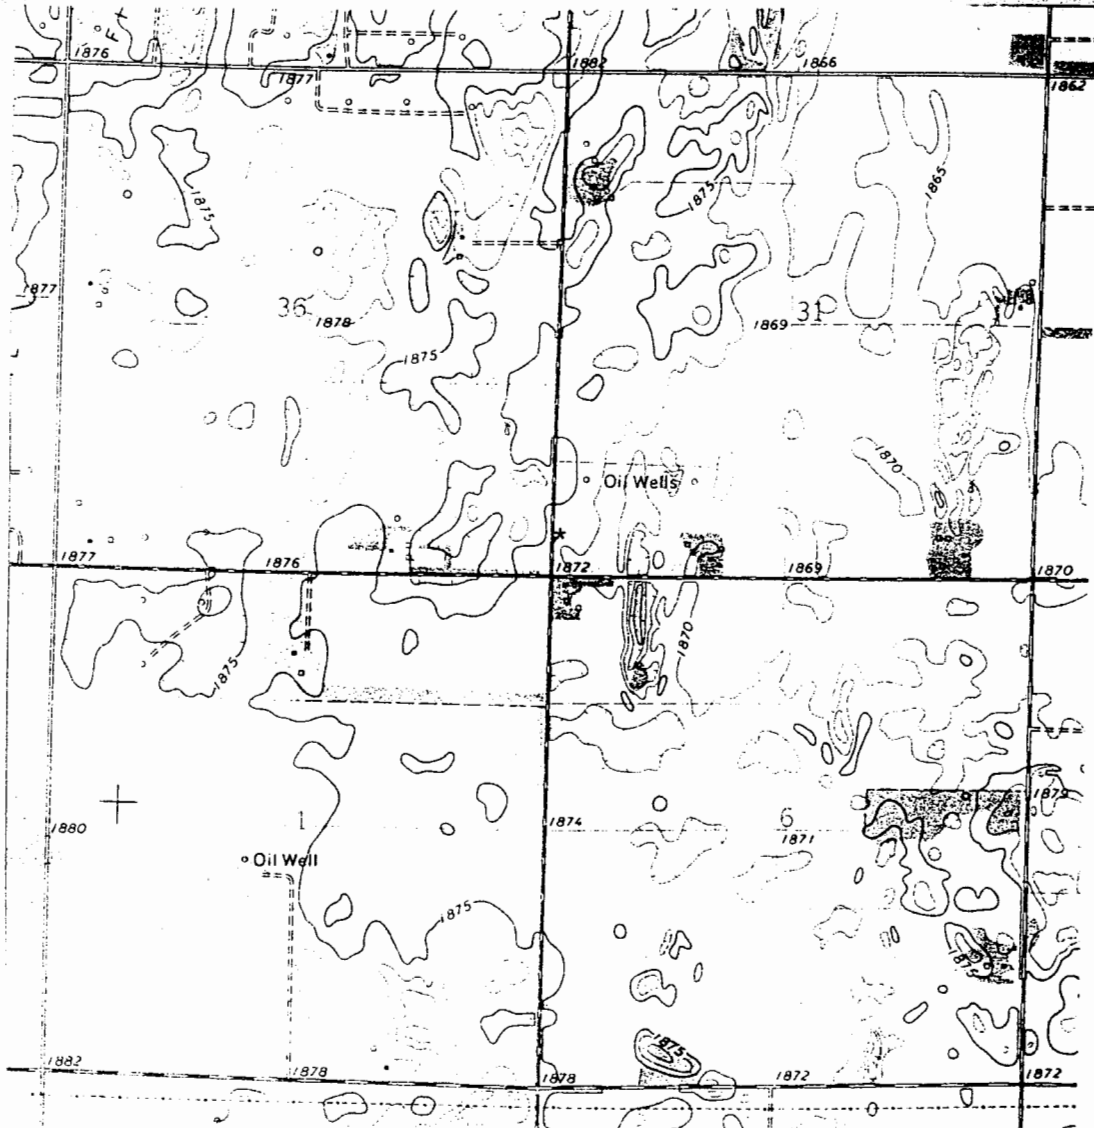

WELL LOCATION *