


1 LOCATION OF WATER WELL:	Fraction	Section	Number	Township	Number	Range	Number
County: <u>Stafford</u>	<u>SW ¼ SW ¼ SE ¼</u>	<u>7</u>		<u>21</u>		<u>12</u>	<input checked="" type="checkbox"/> W

Distance and direction from nearest town or city street address of well if located within city?
5 3/4 East, 3 1/2 North of Seward

2 WATER WELL OWNER: <u>FG Hill / James Nolte</u> <u>9431 E. Central / 2433 Walnut Dr.</u> RR #, St. Address, Box #: <u>Ste 100 / Great Bend, KS 67530</u> City, State, ZIP Code: <u>Wichita, Ks 67206/</u>	<u>SFW 3332</u> Board of Agriculture, Division of Water Resources Application Number: <u>20060313</u>
---	---

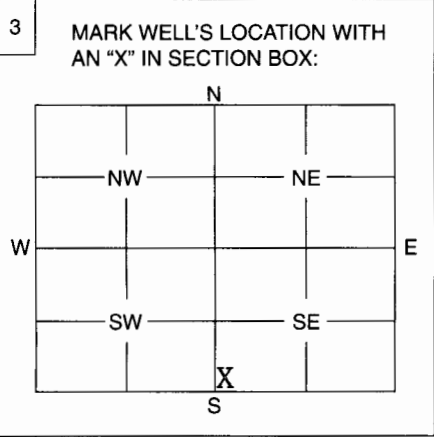

4 DEPTH OF WELL 70 ft.
 WELL'S STATIC WATER LEVEL 20 ft.

WELL WAS USED AS:

1 Domestic	5 Public Water Supply	9 Dewatering
2 Irrigation	6 <u>Oil Field Water Supply</u>	10 Monitoring Well
3 Feedlot	7 Domestic (Lawn & Garden)	11 Injection Well
4 Industrial	8 Air Conditioning	12 Other

Was a chemical / bacteriological sample submitted to Department? Yes No X.....
 If yes, mo/day/yr sample was submitted

Water Well Disinfected: Yes HTH. No

5 TYPE OF BLANK CASING USED:

1 Steel	3 RMP (SR)	5 Wrought	7 Fiberglass	9 Other (Specify below)
2 <u>PVC</u>	4 ABS	6 Asbestos-Cement	8 Concrete Tile

Blank casing diameter 5 in. Was casing pulled? Yes No X..... If yes, how much

Casing height above or below land surface 30 in.

6 GROUT PLUG MATERIAL: 1 Neat cement 2 Cement grout 3 Bentonite 4 Other hole plug

Grout Plug Intervals: From 5 ft. to 3 ft., From ft. to ft., From 70 to 5 ft.

What is the nearest source of possible contamination:

1 Septic tank	6 Seepage pit	11 Fuel storage	16 Other (specify below)
2 Sewer lines	7 Pit privy	12 Fertilizer storage
3 Watertight sewer lines	8 Sewage lagoon	13 Insecticide storage	
4 Lateral lines	9 Feedyard	14 Abandoned water well	
5 Cess pool	10 Livestock pens	15 <u>Oil well/Gas well</u>	

Direction from well? North How many feet? 600

FROM	TO	PLUGGING MATERIALS
<u>70</u>	<u>5</u>	<u>Hole plug</u>
<u>5</u>	<u>3</u>	<u>Cement</u>
<u>3</u>	<u>0</u>	<u>Top soil</u>

7 CONTRACTOR'S OF LANDOWNER'S CERTIFICATION: This water well was plugged under my jurisdiction and was completed on (mo/day/year) 12-1-06 and this record is true to the best of my knowledge and belief. Kansas Water Well Contractor's License No. 134 This Water Well Record was completed on (mo/day/year) 12-7-06 under the business name of Rosencrantz- Benis by (signature) [Signature]

INSTRUCTIONS: Use typewriter or ball point pen. Please press firmly and print clearly. Please fill in blanks, underline or circle the correct answers. Send top three copies to Kansas Department of Health and Environment, Bureau of Water, Geology Section, 1000 SW Jackson St., Ste. 420, Topeka, Kansas 66612-1367. Telephone: 785/296-5522. Send one to Water Well Owner and retain one for your records.