


1 LOCATION OF WATER WELL: Fraction NE 1/4 NE 1/4 SW 1/4 Section Number 5 Township Number T 21 S Range Number R 12 E/W
 County: STAFFORD

Distance and direction from nearest town or city street address of well if located within city?
 9-N 1/2 W. OF HUDSON, KS.

2 WATER WELL OWNER: VIRGIL SALEM
 RR#, St. Address, Box #: RT 2 BOX 96 Board of Agriculture, Division of Water Resources
 City, State, ZIP Code: ELLINWOOD, KS. 67526 Application Number:

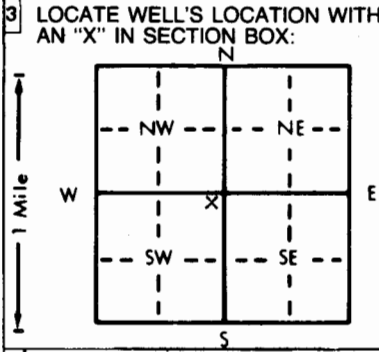

4 DEPTH OF COMPLETED WELL: 66 ft. ELEVATION:
 Depth(s) Groundwater Encountered 1. ft. 2. ft. 3. ft.
 WELL'S STATIC WATER LEVEL: 22 ft. below land surface measured on mo/day/yr
 Pump test data: Well water was ft. after hours pumping gpm
 Est. Yield gpm: Well water was ft. after hours pumping gpm
 Bore Hole Diameter: 9 in. to ft., and in. to ft.
 WELL WATER TO BE USED AS:
 5 Public water supply 8 Air conditioning 11 Injection well
 XX1 Domestic 3 Feedlot 6 Oil field water supply 9 Dewatering 12 Other (Specify below)
 2 Irrigation 4 Industrial 7 Lawn and garden only 10 Monitoring well
 Was a chemical/bacteriological sample submitted to Department? Yes No X; If yes, mo/day/yr sample was sub-
 mitted Water Well Disinfected? Yes X No

5 TYPE OF BLANK CASING USED:
 1 Steel 3 RMP (SR) 5 Wrought iron 8 Concrete tile CASING JOINTS: Glued X Clamped
 XX2 PVC 4 ABS 6 Asbestos-Cement 9 Other (specify below) Welded
 7 Fiberglass Threaded
 Blank casing diameter 56 in. to 66 ft., Dia in. to ft., Dia in. to ft.
 Casing height above land surface 18 in., weight lbs./ft. Wall thickness or gauge No.
 TYPE OF SCREEN OR PERFORATION MATERIAL:
 1 Steel 3 Stainless steel 5 Fiberglass XX7 PVC 10 Asbestos-cement
 2 Brass 4 Galvanized steel 6 Concrete tile 9 ABS 12 None used (open hole)
 SCREEN OR PERFORATION OPENINGS ARE:
 1 Continuous slot XX Mill slot 5 Gauzed wrapped 8 Saw cut 11 None (open hole)
 2 Louvered shutter 4 Key punched 6 Wire wrapped 9 Drilled holes
 7 Torch cut 10 Other (specify)
 SCREEN-PERFORATED INTERVALS: From 56 ft. to 66 ft., From ft. to ft.
 From ft. to ft., From ft. to ft.
 GRAVEL PACK INTERVALS: From 23 ft. to 66 ft., From ft. to ft.
 From ft. to ft., From ft. to ft.

6 GROUT MATERIAL: 1 Neat cement 2 Cement grout XX3 Bentonite 4 Other
 Grout Intervals: From 3 ft. to 23 ft., From ft. to ft., From ft. to ft.
 What is the nearest source of possible contamination:
 1 Septic tank 4 Lateral lines 7 Pit privy 10 Livestock pens 14 Abandoned water well
 2 Sewer lines 5 Cess pool 8 Sewage lagoon 11 Fuel storage 15 Oil well/Gas well
 3 Watertight sewer lines 6 Seepage pit 9 Feedyard 12 Fertilizer storage 16 Other (specify below)
 13 Insecticide storage NONE
 Direction from well? How many feet?

FROM	TO	LITHOLOGIC LOG	FROM	TO	PLUGGING INTERVALS
0	3	TOP SOIL			
3	22	CLAY			
22	35	GRAVEL			
35	50	CLAY			
50	66	GRAVEL			

7 CONTRACTOR'S OR LANDOWNER'S CERTIFICATION: This water well was (1) constructed, (2) reconstructed, or (3) plugged under my jurisdiction and was completed on (mo/day/year) 11-29-92 and this record is true to the best of my knowledge and belief. Kansas Water Well Contractor's License No. 462-B This Water Well Record was completed on (mo/day/yr) 4-3-92 under the business name of SAM'S WATER WELL SERVICE by (signature) *Yona Rayburn*