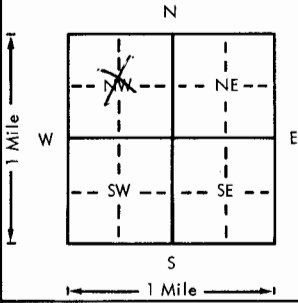


USE TYPEWRITER OR BALL POINT PEN—PRESS FIRMLY, PRINT CLEARLY.

WATER WELL RECORD  
KSA 82a-1201-1215

Kansas Department of Health and Environment—Division of Environment  
(Water well Contractors)  
Topeka, Kansas 66620

1. Location of well:		County <b>STAFFORD</b>	Fraction <b>C/NW</b> 1/4 1/4 1/4	Section number <b>8</b>	Township number <b>21</b> T 21 S	Range number <b>12</b> R 12 E		
2. Distance and direction from nearest town or city: <b>8.5 of Dartmouth</b> Street address of well location if in city:			3. Owner of well: <b>Virgil Salem</b> R.R. or street: <b>Rt. 2</b> City, state, zip code: <b>Ellinwood KS,</b>					
4. Locate with "X" in section below: 			Sketch map:		6. Bore hole dia. <b>2 1/2</b> in. Completion date <b>5-28-75</b> Well depth <b>113</b> ft.			
5. Type and color of material			From	To	7. <input type="checkbox"/> Cable tool <input checked="" type="checkbox"/> Rotary <input type="checkbox"/> Driven <input type="checkbox"/> Dug <input type="checkbox"/> Hollow rod <input type="checkbox"/> Jetted <input type="checkbox"/> Bored <input type="checkbox"/> Reverse rotary			
			Top Soil		0	3	8. Use: <input type="checkbox"/> Domestic <input type="checkbox"/> Public supply <input type="checkbox"/> Industry <input checked="" type="checkbox"/> Irrigation <input type="checkbox"/> Air conditioning <input type="checkbox"/> Stock <input type="checkbox"/> Lawn <input type="checkbox"/> Oil field water <input type="checkbox"/> Other	
			Clay		3	21	9. Casing: Material <b>steel</b> Height: <b>Above</b> or below Threaded <input type="checkbox"/> Welded <input type="checkbox"/> Surface <b>18</b> in. RMP <input type="checkbox"/> PVC <input type="checkbox"/> Weight <input type="checkbox"/> lbs./ft. Dia. <b>16</b> in. to <b>113</b> ft. depth; Wall Thickness: inches or Dia. <input type="checkbox"/> in. to <input type="checkbox"/> ft. depth; gage No. <b>7</b>	
			Sand Gravel		21	23	10. Screen: Manufacturer's name <b>Doerfs</b> Type <b>steel</b> Dia. <b>16</b> <del>lot/gauge</del> <b>3/16</b> Length <b>40</b> Set between <b>73</b> ft. and <b>113</b> ft. ft. and <input type="checkbox"/> ft. Gravel pack? <input checked="" type="checkbox"/> Size range of material <b>1/2 3/4 3/8</b>	
			Clay		23	32	11. Static water level: <input type="checkbox"/> mo./day/yr. <b>8</b> ft. below land surface Date <b>2-13-75</b>	
			Sand Gravel		32	34	12. Pumping level below land surfaces: <b>8</b> ft. after <b>1</b> hrs. pumping <b>1200</b> g.p.m. <input type="checkbox"/> ft. after <input type="checkbox"/> hrs. pumping <input type="checkbox"/> g.p.m. Estimated maximum yield <b>1400</b> g.p.m.	
			Clay		34	42	13. Water sample submitted: <input type="checkbox"/> mo./day/yr. <input checked="" type="checkbox"/> Yes <input type="checkbox"/> No Date <b>2-13-75</b>	
			Sand Gravel		42	52	14. Well head completion: <input type="checkbox"/> Pitless adapter <input type="checkbox"/> Inches above grade	
			Rusty Cement Sand		52	54	15. Well grouted? <input checked="" type="checkbox"/> With: <input type="checkbox"/> Neat cement <input type="checkbox"/> Bentonite <input checked="" type="checkbox"/> Concrete Depth: From <b>0</b> ft. to <b>10</b> ft.	
			Sand & Gravel		54	60	16. Nearest source of possible contamination: ft. <b>1000</b> Direction <b>S</b> Type <b>oil well</b> Well disinfected upon completion? <input type="checkbox"/> Yes <input type="checkbox"/> No	
Green Clay		60	61	17. Pump: <input type="checkbox"/> Not installed Manufacturer's name <b>WLR</b> Model number <b>3-CHC-12</b> HP <b>40</b> Volts <input type="checkbox"/> Length of drop pipe <b>60</b> ft. capacity <b>1000</b> g.p.m. Type: <input type="checkbox"/> Submersible <input checked="" type="checkbox"/> Turbine <input type="checkbox"/> Jet <input type="checkbox"/> Reciprocating <input type="checkbox"/> Centrifugal <input type="checkbox"/> Other				
Sand & Gravel		61	71	20. Water well contractor's certification: This well was drilled under my jurisdiction and this report is true to the best of my knowledge and belief. <b>Rosencrants-Bemis 134</b> Business name <b>Great Bend, KS.</b> License No. <input type="checkbox"/> Address <b>Great Bend, KS.</b> Signed <b>Virgil Salem</b> Date <b>4/7/75</b> Authorized representative				
Clay		71	72					
Good Sand & Gravel		72	110					
Clay		110						
(Use a second sheet if needed)								
18. Elevation:		19. Remarks:		20. Water well contractor's certification:				
Topography: <input type="checkbox"/> Hill <input type="checkbox"/> Slope <input checked="" type="checkbox"/> Upland <input type="checkbox"/> Valley								

21-120-8  
T  
R  
Sec  
1/4  
1/4  
1/4