


1 LOCATION OF WATER WELL: County: **Stafford** Fraction: **C 1/4 n 1/2 1/4 se 1/4** Section Number: **9** Township Number: **T 21 S** Range Number: **R 12 E/W**

Distance and direction from nearest town or city street address of well if located within city?
8 1/2 north -3/4 east of Hudson, Ks.

2 WATER WELL OWNER: **Leo Setser Mustang Drilling**
 RR#, St. Address, Box #: **Hudson, Ks. Box 1609**
 City, State, ZIP Code: **Great Bend, Ks. 67530**
 Board of Agriculture, Division of Water Resources
 Application Number: **T84-257**

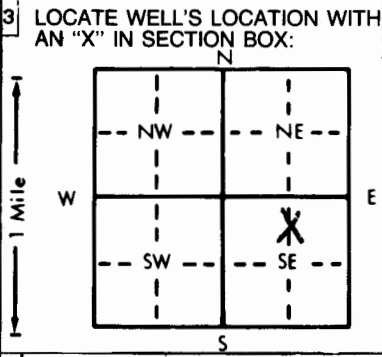

4 DEPTH OF COMPLETED WELL: **80** ft. ELEVATION:

Depth(s) Groundwater Encountered 1. **1.1** ft. 2. ft. 3. ft.

WELL'S STATIC WATER LEVEL **29** ft. below land surface measured on mo/day/yr **5-16-84**

Pump test data: Well water was ft. after hours pumping gpm

Est. Yield **na** gpm: Well water was ft. after hours pumping gpm

Bore Hole Diameter **10** in. to **80** ft., and in. to ft.

WELL WATER TO BE USED AS:

5 Public water supply	8 Air conditioning	11 Injection well
1 Domestic	3 Feedlot	6 Oil field water supply
2 Irrigation	4 Industrial	7 Lawn and garden only
		10 Observation well
		9 Dewatering
		12 Other (Specify below)

Was a chemical/bacteriological sample submitted to Department? Yes.....No **X**.....; If yes, mo/day/yr sample was submitted

Water Well Disinfected? Yes **hth** No

5 TYPE OF BLANK CASING USED:

1 Steel	3 RMP (SR)	5 Wrought iron	8 Concrete tile	CASING JOINTS: Glued X Clamped
2 PVC	4 ABS	6 Asbestos-Cement	9 Other (specify below)	Welded
		7 Fiberglass		Threaded

Blank casing diameter **5** in. to **60** ft., Dia in. to ft., Dia in. to ft.

Casing height above land surface **18** in., weight lbs./ft. Wall thickness or gauge No. **258**

TYPE OF SCREEN OR PERFORATION MATERIAL:

1 Steel	3 Stainless steel	5 Fiberglass	7 PVC	10 Asbestos-cement
2 Brass	4 Galvanized steel	6 Concrete tile	8 RMP (SR)	11 Other (specify)
			9 ABS	12 None used (open hole)

SCREEN OR PERFORATION OPENINGS ARE:

1 Continuous slot	3 Mill slot	5 Gauzed wrapped	8 Saw cut	11 None (open hole)
2 Louvered shutter	4 Key punched	6 Wire wrapped	9 Drilled holes	
		7 Torch cut	10 Other (specify)	

SCREEN-PERFORATED INTERVALS: From **60** ft. to **80** ft., From ft. to ft.

GRAVEL PACK INTERVALS: From **10** ft. to **80** ft., From ft. to ft.

6 GROUT MATERIAL: 1 Neat cement 2 Cement grout 3 Bentonite 4 Other

Grout intervals: From **0** ft. to **10** ft., From ft. to ft., From ft. to ft.

What is the nearest source of possible contamination:

1 Septic tank	4 Lateral lines	7 Pit privy	10 Livestock pens	14 Abandoned water well
2 Sewer lines	5 Cess pool	8 Sewage lagoon	11 Fuel storage	15 Oil well/Gas well
3 Watertight sewer lines	6 Seepage pit	9 Feedyard	12 Fertilizer storage	16 Other (specify below)
			13 Insecticide storage	

Direction from well? **west** How many feet? **100**

FROM	TO	LITHOLOGIC LOG	FROM	TO	LITHOLOGIC LOG
0	9	Sand			
9	32	Sand with clay layers			
32	56	Sand and gravel with clay layers			
56	75	Sand and gravel thin clay layer			
75	80	Green clay			

7 CONTRACTOR'S OR LANDOWNER'S CERTIFICATION: This water well was (1) constructed, (2) reconstructed, or (3) plugged under my jurisdiction and was completed on (mo/day/year) **5-16-84** and this record is true to the best of my knowledge and belief. Kansas Water Well Contractor's License No. **134** This Water Well Record was completed on (mo/day/yr) **7-31-84** under the business name of **Rosencrantz-Bemis Ent.** by (signature) *Alma Dodson*

INSTRUCTIONS: Use typewriter or ball point pen, PLEASE PRESS FIRMLY and PRINT clearly. Please fill in blanks, underline or circle the correct answers. Send top three copies to Kansas Department of Health and Environment, Division of Environment, Environmental Geology Section, Topeka, KS 66620. Send one to WATER WELL OWNER and retain one for your records.