


KRUEGER #2

1 LOCATION OF WATER WELL:	Fraction	Section Number	Township Number	Range Number
County: STAFFORD	NW 1/4 SW 1/4 NW 1/4	9	T 21 S	R 12 E 10

Distance and direction from nearest town or city street address of well if located within city?
HUDSON 9 1/4 N EASTSIDE

2 WATER WELL OWNER: L.O. DRILLING CO. INC GE. KRUEGER GREAT BEND, KS.
 RR#, St. Address, Box #: 324 Board of Agriculture, Division of Water Resources
 City, State, ZIP Code: GREAT BEND, KS 67530 Application Number: 781-941

3 LOCATE WELL'S LOCATION WITH AN "X" IN SECTION BOX:

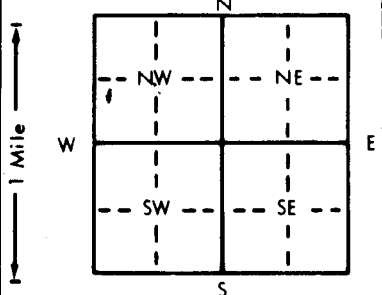

4 DEPTH OF COMPLETED WELL: 75 ft. ELEVATION:

Depth(s) Groundwater Encountered 1. 35 ft. 2. 50 ft. 3. ft.

WELL'S STATIC WATER LEVEL . . . 19 ft. below land surface measured on mo/day/yr . . . 1-12-82

Pump test data: Well water was . . . ft. after . . . hours pumping . . . gpm

Est. Yield . . . gpm: Well water was . . . ft. after . . . hours pumping . . . gpm

Bore Hole Diameter: 7 1/8 in. to . . . 7 9/16 ft., and . . . in. to . . . ft.

WELL WATER TO BE USED AS:

5 Public water supply	8 Air conditioning	11 Injection well
1 Domestic	3 Feedlot	6 Oil field water supply
2 Irrigation	4 Industrial	7 Lawn and garden only
		9 Dewatering
		10 Observation well
		12 Other (Specify below)

Was a chemical/bacteriological sample submitted to Department? Yes No; If yes, mo/day/yr sample was submitted

Water Well Disinfected? Yes No

5 TYPE OF BLANK CASING USED:

1 Steel	3 RMP (SR)	5 Wrought iron	8 Concrete tile	CASING JOINTS: Glued <input checked="" type="checkbox"/> Clamped
2 PVC	4 ABS	6 Asbestos-Cement	9 Other (specify below)	Welded
		7 Fiberglass		Threaded

Blank casing diameter . . . 5 in. to . . . 5 5/8 ft., Dia . . . in. to . . . ft., Dia . . . in. to . . . ft.

Casing height above land surface . . . 12 in., weight . . . 2.65 lbs./ft. Wall thickness or gauge No. . . 214

TYPE OF SCREEN OR PERFORATION MATERIAL:

1 Steel	3 Stainless steel	5 Fiberglass	8 RMP (SR)	10 Asbestos-cement
2 Brass	4 Galvanized steel	6 Concrete tile	9 ABS	11 Other (specify)
				12 None used (open hole)

SCREEN OR PERFORATION OPENINGS ARE: 1/8

1 Continuous slot	3 Mill slot	5 Gauzed wrapped	8 Saw cut	11 None (open hole)
2 Louvered shutter	4 Key punched	6 Wire wrapped	9 Drilled holes	
		7 Torch cut	10 Other (specify)	

SCREEN-PERFORATED INTERVALS: From . . . 55 ft. to . . . 75 ft., From . . . ft. to . . . ft.

GRAVEL PACK INTERVALS: From . . . 45 ft. to . . . 75 ft., From . . . ft. to . . . ft.

6 GROUT MATERIAL: 1 Neat cement 2 Cement grout 3 Bentonite 4 Other

Grout intervals: From . . . 0 ft. to . . . 10 ft., From . . . ft. to . . . ft., From . . . ft. to . . . ft.

What is the nearest source of possible contamination: NONE

1 Septic tank	4 Lateral lines	7 Pit privy	10 Livestock pens	14 Abandoned water well
2 Sewer lines	5 Cess pool	8 Sewage lagoon	11 Fuel storage	15 Oil well/Gas well
3 Watertight sewer lines	6 Seepage pit	9 Feedyard	12 Fertilizer storage	16 Other (specify below)
			13 Insecticide storage	

Direction from well? How many feet?

FROM	TO	LITHOLOGIC LOG	FROM	TO	LITHOLOGIC LOG
10	35	SANDY CLAY			
35	40	GRAVEL			
40	50	CLAY			
50	75	GRAVEL			

7 CONTRACTOR'S OR LANDOWNER'S CERTIFICATION: This water well was (1) constructed, (2) reconstructed, or (3) plugged under my jurisdiction and was completed on (mo/day/year) . . . 1-12-82 . . . and this record is true to the best of my knowledge and belief. Kansas Water Well Contractor's License No. . . 389 . . . This Water Well Record was completed on (mo/day/yr) . . . 1-22-82 . . . under the business name of PEISEN WATER WELL SERV. INC by (signature) *Peisen*

INSTRUCTIONS: Use typewriter or ball point pen, PLEASE PRESS FIRMLY and PRINT clearly. Please fill in blanks, underline or circle the correct answers. Send top three copies to Kansas Department of Health and Environment, Division of Environment, Environmental Geology Section, Topeka, KS 66620. Send one to WATER WELL OWNER and retain one for your records.

OFFICE USE ONLY
T
R
SEC.
NW 1/4 SW 1/4 NW 1/4