USE TYPEWRITER OR BALL POINT PEN-PRESS FIRMLY, PRINT CLEARLY.

WATER WELL RECORD
KSA 82a-1201-1215

Kansas Department of Health and Environment-Division of Environment
(Water well Contractors)
Topeka, Kansas 66620

1. Location of well:	County: Stafford	Fraction: CS½ S½ SW1/4 (1/4 1/4)	Section number: 11	Township number: T 21 S	Range number: R 12 E/W

2. Distance and direction from nearest town or city: 7s 1 3/4 w
Street address of well location if in city: Ellinwood, Ks.

3. Owner of well: Kurt Rugan
R.R. or street: R2 Ellinwood, Ks.
City, state, zip code:

4. Locate with "X" in section below:

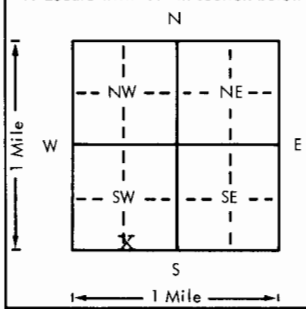

Sketch map:

6. Bore hole dia. 8 in. Completion date
Well depth 60 ft. 10-20-77

7. __ Cable tool X Rotary __ Driven __ Dug
__ Hollow rod __ Jetted __ Bored __ Reverse rotary

8. Use: __ Domestic __ Public supply __ Industry
__ Irrigation __ Air conditioning X Stock
__ Lawn __ Oil field water __ Other

9. Casing: Material
Threaded ___ Welded ___
RMP ___ PVC ___
Dia. 5 in. to 62 ft. depth
Dia. ___ in. to ___ ft. depth
Height: Above or below
Surface 12 in.
Weight ___ lbs./ft.
Wall Thickness: inches or gage No. Sch 40

10. Screen: Manufacturer's name Jetstream
Type pvc Dia. 5"
Slot/gauze 1/32" Length 20'
Set between 40 ft. and 60 ft.
ft. and ft.
Gravel pack? X Size range of material 1/8-3/4"

11. Static water level: mo./day/yr.
24 ft. below land surface Date 10-20-77

12. Pumping level below land surfaces:
___ ft. after ___ hrs. pumping ___ g.p.m.
___ ft. after ___ hrs. pumping ___ g.p.m.
Estimated maximum yield 40 g.p.m.

13. Water sample submitted: mo./day/yr.
__ Yes X No Date

14. Well head completion:
__ Pitless adapter 12 Inches above grade

15. Well grouted? X
With: X Neat cement ___ Bentonite ___ Concrete
Depth: From 0 ft. to 10 ft.

16. Nearest source of possible contamination:
ft. 50 Direction n Type stock
Well disinfected upon completion? X Yes ___ No

17. Pump: X Not installed
Manufacturer's name
Model number ___ HP ___ Volts ___
Length of drop pipe ___ ft. capacity ___ g.p.m.
Type:
__ Submersible __ Turbine
__ Jet __ Reciprocating
__ Centrifugal __ Other

5. Type and color of material	From	To
Top Soil-Clay	0	25
Sand	25	35
Sand-Gravel	35	60

(Use a second sheet if needed)

18. Elevation:
Topography:
__ Hill
__ Slope
X Upland
__ Valley

19. Remarks:

20. Water well contractor's certification:
This well was drilled under my jurisdiction and this report is true to the best of my knowledge and belief.
Business name Kellys Waterwell License No. Ser 186
Address R2 Great Bend, Ks.
Signed Kelly Price Date 8-9-79
Authorized representative

T 21 R 12 E/W Sec 11 1/4 CS½ 1/4 SW 1/4

Forward the white, blue and pink copies to the Department of Health and Environment

Form WWC-5

MI-1023