


1 LOCATION OF WATER WELL: County: Stafford	Fraction SE 1/4 SW 1/4 SW 1/4	Section Number 17	Township Number T 21 S	Range Number R 12W E/W
--	---	-----------------------------	----------------------------------	----------------------------------

Distance and direction from nearest town or city street address of well if located within city?
1 E, 8 N of Hudson, Kansas

2 WATER WELL OWNER: Bill Heaton	Abercrombie Drilling	Heaton #9
RR#, St. Address, Box # Hudson, Kansas	801 Union Center	Board of Agriculture, Division of Water Resources
City, State, ZIP Code: 67545	Wichita, Kansas 67202	Application Number: 88-203

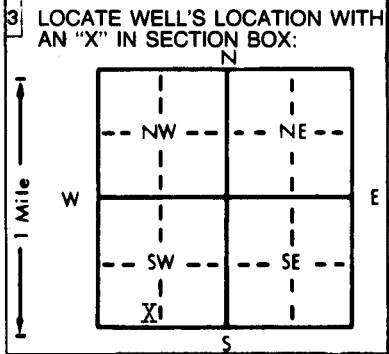

4 DEPTH OF COMPLETED WELL: 80 ft. ELEVATION: Unknown	Depth(s) Groundwater Encountered 1 20 ft. 2. ft. 3. ft.	
WELL'S STATIC WATER LEVEL 20 ft. below land surface measured on mo/day/yr 4/13/88		
Pump test data: Well water was ft. after hours pumping gpm		
Est. Yield 60 gpm: Well water was ft. after hours pumping gpm		
Bore Hole Diameter: 8 in. to 80 ft., and in. to ft.		
WELL WATER TO BE USED AS:		
5 Public water supply	8 Air conditioning	11 Injection well
1 Domestic	3 Feedlot	6 <u>Oil field water supply</u>
2 Irrigation	4 Industrial	9 Dewatering
	7 Lawn and garden only	12 Other (Specify below)
Was a chemical/bacteriological sample submitted to Department? Yes <u>No</u> ; If yes, mo/day/yr sample was submitted		
Water Well Disinfected? Yes <u>No</u>		

5 TYPE OF BLANK CASING USED:	5 Wrought iron	8 Concrete tile	CASING JOINTS: <u>Glued</u> Clamped
1 Steel	3 RMP (SR)	6 Asbestos-Cement	9 Other (specify below)
<u>2 PVC</u>	4 ABS	7 Fiberglass	10 Asbestos-cement
Blank casing diameter 5 in. to 60 ft., Dia in. to ft., Dia in. to ft.		Casing height above land surface 12 in., weight 2.8 lbs./ft. Wall thickness or gauge No. Sch. 40	
TYPE OF SCREEN OR PERFORATION MATERIAL:			
1 Steel	3 Stainless steel	5 Fiberglass	8 RMP (SR)
2 Brass	4 Galvanized steel	6 Concrete tile	9 ABS
SCREEN OR PERFORATION OPENINGS ARE:		7 <u>PVC</u>	10 Asbestos-cement
1 Continuous slot	3 Mill slot	5 Gauzed wrapped	8 <u>Saw cut</u>
2 Louvered shutter	4 Key punched	6 Wire wrapped	9 Drilled holes
SCREEN-PERFORATED INTERVALS: From 60 ft. to 80 ft., From ft. to ft.		7 Torch cut	10 Other (specify)
GRAVEL PACK INTERVALS: From 20 ft. to 80 ft., From ft. to ft.		8 <u>Saw cut</u>	11 None (open hole)
		9 Drilled holes	

6 GROUT MATERIAL: <u>1 Neat cement</u>	2 Cement grout	3 Bentonite	4 Other
Grout Intervals: From 0 ft. to 20 ft., From ft. to ft., From ft. to ft.			
What is the nearest source of possible contamination:			
1 Septic tank	4 Lateral lines	7 Pit privy	10 Livestock pens
2 Sewer lines	5 Cess pool	8 Sewage lagoon	11 Fuel storage
3 Watertight sewer lines	6 Seepage pit	9 Feedyard	12 Fertilizer storage
			13 Insecticide storage
			14 Abandoned water well
			<u>15 Oil well/Gas well</u>
			16 Other (specify below)
Direction from well? <u>South</u>		How many feet? 60	

FROM	TO	LITHOLOGIC LOG	FROM	TO	LITHOLOGIC LOG
0	30	Clay			
30	80	Sand and Gravel			

7 CONTRACTOR'S OR LANDOWNER'S CERTIFICATION: This water well was (1) <u>constructed</u> , (2) reconstructed, or (3) plugged under my jurisdiction and was completed on (mo/day/year) 4/13/88 and this record is true to the best of my knowledge and belief. Kansas	Water Well Contractor's License No. 186 This Water Well Record was completed on (mo/day/yr) 5/30/88
under the business name of Kelly's Water Well Service by (signature)	

INSTRUCTIONS: Use typewriter or ball point pen. PLEASE PRESS FIRMLY and PRINT clearly. Please fill in blanks, underline or circle the correct answers. Send top three copies to Kansas Department of Health and Environment, Bureau of Water Protection, Topeka, Kansas 66620-7320, Telephone: 913-862-9360. Send one to WATER WELL OWNER and retain one for your records.