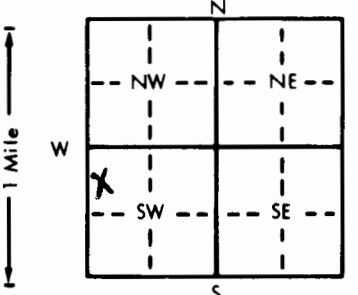


WIDENER #1

WATER WELL RECORD

Form WWC-5

KSA 82a-1212

1 LOCATION OF WATER WELL:		Fraction	Section Number	Township Number	Range Number
County: STAFFORD		SW 1/4 NW 1/4 SW 1/4	23	T 21 S	R 12 E
Distance and direction from nearest town or city street address of well if located within city?					
HUDSON 6 1/2 N 2 E 1/3 N EASTSIDE					
2 WATER WELL OWNER:		A4K. WIDENER, HUDSON, KS.			
RR#, St. Address, Box # : BOX 506		Board of Agriculture, Division of Water Resources			
City, State, ZIP Code : RUSSELL, KS 67665		Application Number: T84-982			
3 LOCATE WELL'S LOCATION WITH AN "X" IN SECTION BOX:		4 DEPTH OF COMPLETED WELL: 120 ft. ELEVATION:			
		Depth(s) Groundwater Encountered 1. 70 ft. 2. 95 ft. 3. ft.			
		WELL'S STATIC WATER LEVEL 26 ft. below land surface measured on mo/day/yr 12-12-84			
		Pump test data: Well water was ft. after hours pumping gpm			
		Est. Yield gpm: Well water was ft. after hours pumping gpm			
		Bore Hole Diameter 7 1/8 in. to 120 ft. and in. to ft.			
		WELL WATER TO BE USED AS:			
		5 Public water supply 8 Air conditioning 11 Injection well			
		1 Domestic 3 Feedlot 6 Oil field water supply 9 Dewatering 12 Other (Specify below)			
		2 Irrigation 4 Industrial 7 Lawn and garden only 10 Observation well			
		Was a chemical/bacteriological sample submitted to Department? Yes No; If yes, mo/day/yr sample was submitted			
		Water Well Disinfected? Yes No			
5 TYPE OF BLANK CASING USED:		CASING JOINTS: Glued XX Clamped			
1 Steel 3 RMP (SR) 5 Wrought iron 8 Concrete tile		Welded			
2 PVC 4 ABS 6 Asbestos-Cement 9 Other (specify below)		Threaded			
Blank casing diameter 5 in. to 100 ft. Dia. in. to ft. Dia. in. to ft.					
Casing height above land surface 12 in. weight 265 lbs./ft. Wall thickness or gauge No. 214					
TYPE OF SCREEN OR PERFORATION MATERIAL:		7 PVC 10 Asbestos-cement			
1 Steel 3 Stainless steel 5 Fiberglass 8 RMP (SR) 11 Other (specify)					
2 Brass 4 Galvanized steel 6 Concrete tile 9 ABS 12 None used (open hole)					
SCREEN OR PERFORATION OPENINGS ARE: 18		5 Gauzed wrapped 8 Saw cut 11 None (open hole)			
1 Continuous slot 3 Mill slot 6 Wire wrapped 9 Drilled holes					
2 Louvered shutter 4 Key punched 7 Torch cut 10 Other (specify)					
SCREEN-PERFORATED INTERVALS: From 100 ft. to 120 ft. From ft. to ft. From ft. to ft.					
GRAVEL PACK INTERVALS: From 90 ft. to 120 ft. From ft. to ft. From ft. to ft.					
6 GROUT MATERIAL:		3 Bentonite 4 Other			
Grout Intervals: From 0 ft. to 10 ft. From ft. to ft. From ft. to ft.					
What is the nearest source of possible contamination: NONE		10 Livestock pens 14 Abandoned water well			
1 Septic tank 4 Lateral lines 7 Pit privy 11 Fuel storage 15 Oil well/Gas well					
2 Sewer lines 5 Cess pool 8 Sewage lagoon 12 Fertilizer storage 16 Other (specify below)					
3 Watertight sewer lines 6 Seepage pit 9 Feedyard 13 Insecticide storage					
Direction from well?		How many feet?			
FROM	TO	LITHOLOGIC LOG	FROM	TO	LITHOLOGIC LOG
0	5	TOP SOIL			
5	15	CLAY			
15	25	FINE SAND			
25	35	CLAY			
35	40	SANDY CLAY			
40	55	FINE SAND			
55	68	CLAY			
68	70	SANDY CLAY			
70	85	GRAVEL			
85	95	CLAY			
95	120	GRAVEL			
7 CONTRACTOR'S OR LANDOWNER'S CERTIFICATION: This water well was (1) constructed, (2) reconstructed, or (3) plugged under my jurisdiction and was completed on (mo/day/year) 12-12-84 and this record is true to the best of my knowledge and belief. Kansas Water Well Contractor's License No. 389 This Water Well Record was completed on (mo/day/yr) 12-17-84 under the business name of REISER WATER WELL SERV INC. by (signature) Randolph J. Reiser					
INSTRUCTIONS: Use typewriter or ball point pen, PLEASE PRESS FIRMLY and PRINT clearly. Please fill in blanks, underline or circle the correct answers. Send top three copies to Kansas Department of Health and Environment, Division of Environment, Environmental Geology Section, Topeka, KS 66620. Send one to WATER WELL OWNER and retain one for your records.					