

1 LOCATION OF WATER WELL County: <b>Stafford</b>	Fraction <b>SE 1/4 SE 1/4 SE 1/4</b>	Section Number <b>36</b>	Township Number <b>T 21 S</b>	Range Number <b>R 12 EW</b>
---	---	-----------------------------	----------------------------------	--------------------------------

Distance and direction from nearest town or city? **5 mi N, 4 mi E Hudson, Kansas**  
 Street address of well if located within city? **N/A**

2 WATER WELL OWNER: **Kansas Geological Survey/Groundwater Management District #5**  
 RR#, St. Address, Box # :  
 City, State, ZIP Code : **St. John, Kansas 67576**  
 Board of Agriculture, Division of Water Resources  
 Application Number:

3 DEPTH OF COMPLETED WELL... **46** ft. Bore Hole Diameter... **9 7/8** in. to... **46** ft., and... in. to... ft.  
 Well Water to be used as:  
 1 Domestic 3 Feedlot 5 Public water supply 8 Air conditioning 11 Injection well  
 2 Irrigation 4 Industrial 6 Oil field water supply 9 Dewatering **12 Other (Specify below)**  
**Research**  
 Well's static water level... **13.70** ft. below land surface measured on... **Jan.** month... **6** day... **83** year  
 Pump Test Data : Well water was... ft. after... hours pumping... gpm  
 Est. Yield gpm: Well water was... ft. after... hours pumping... gpm


4 TYPE OF BLANK CASING USED:  
 1 Steel 3 RMP (SR) 5 Wrought iron 8 Concrete tile Casing Joints: **Glued** Clamped  
**2 PVC** 4 ABS 6 Asbestos-Cement 9 Other (specify below) Welded  
 7 Fiberglass Threaded  
 Blank casing dia... **5.0** in. to... **41** ft., Dia... in. to... ft., Dia... in. to... ft.  
 Casing height above land surface... **16** in., weight... lbs./ft. Wall thickness or gauge No. **Schd #40**

TYPE OF SCREEN OR PERFORATION MATERIAL:  
 1 Steel 3 Stainless steel 5 Fiberglass 8 RMP (SR) 10 Asbestos-cement  
 2 Brass 4 Galvanized steel 6 Concrete tile 9 ABS 11 Other (specify)  
 12 None used (open hole)  
 Screen or Perforation Openings Are:  
 1 Continuous slot **3 Mill slot** 5 Gauzed wrapped 8 Saw cut 11 None (open hole)  
 2 Louvered shutter 4 Key punched 6 Wire wrapped 9 Drilled holes  
 7 Torch cut 10 Other (specify)  
 Screen-Perforation Dia... **5.0** in. to... **46** ft., Dia... in. to... ft., Dia... in. to... ft.  
 Screen-Perforated Intervals: From... **41** ft. to... **46** ft., From... ft. to... ft.  
 Gravel Pack Intervals: From... **40** ft. to... **46** ft., From... ft. to... ft.

5 GROUT MATERIAL: **1 Neat cement** 2 Cement grout 3 Bentonite 4 Other  
 Grouted Intervals: From... **0** ft. to... **10** ft., From... ft. to... ft., From... ft. to... ft.  
 What is the nearest source of possible contamination:  
 1 Septic tank 4 Cess pool 7 Sewage lagoon 10 Fuel storage 14 Abandoned water well  
 2 Sewer lines 5 Seepage pit 8 Feed yard 11 Fertilizer storage 15 Oil well/Gas well  
 3 Lateral lines 6 Pit privy 9 Livestock pens 12 Insecticide storage 16 Other (specify below)  
 13 Watertight sewer lines

Direction from well... How many feet... ? Water Well Disinfected? Yes... **No**  
 Was a chemical/bacteriological sample submitted to Department? Yes... **No** If yes, date sample  
 was submitted... month... day... year: Pump installed? Yes... **No**  
 If Yes: Pump Manufacturer's name... Model No... HP... Volts...  
 Depth of Pump Intake... ft. Pumps Capacity rated at... gal./min.  
 Type of pump: 1 Submersible 2 Turbine 3 Jet 4 Centrifugal 5 Reciprocating 6 Other

6 CONTRACTOR'S OR LANDOWNER'S CERTIFICATION: This water well was **(1)** constructed, (2) reconstructed, or (3) plugged under my jurisdiction and was  
 completed on... **10** month... **1** day... **80** year...  
 and this record is true to the best of my knowledge and belief. Kansas Water Well Contractor's License No. ....  
 This Water Well Record was completed on... **1** month... **27** day... **83** year under the business  
 name of... by (signature) **Patrick M Cobb**

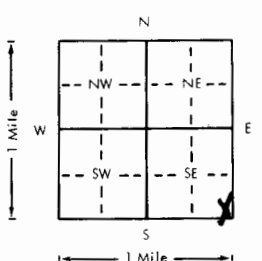7 LOCATE WELL'S LOCATION WITH AN "X" IN SECTION BOX:	FROM	TO	LITHOLOGIC LOG	FROM	TO	LITHOLOGIC LOG
						

ELEVATION: **1804**  
 Depth(s) Groundwater Encountered 1. .... ft. 2. .... ft. 3. .... ft. 4. .... ft. (Use a second sheet if needed)


INSTRUCTIONS: Use typewriter or ball point pen, please press firmly and PRINT clearly. Please fill in blanks, underline or circle the correct answers. Send top three copies to the Kansas Department of Health and Environment, Division of Environment, Water Well Contractors, Topeka, KS 66620. Send one to WATER WELL OWNER and retain one for your records.

OFFICE USE ONLY  
T 21  
R 12  
EW W SEC 36  
SE 1/4 SE 1/4 SE 1/4



*SW*  
SITE NUMBER : L7(KP2)  
SITE LOCATION : ~~SE~~ SE SE  
LEGAL LOCATION: SEC36 T21S R12W  
COUNTY : STAFFORD

LANDOWNER: JEROME SAYLER, M.D.  
ADDRESS : 2053 VAN BUREN  
GREAT BEND, KANSAS 67530  
PHONE NO.: 316-793-9291  
TENANT : MARVIN SITTNER  
HUDSON, KANSAS 67545  
316-458-4755

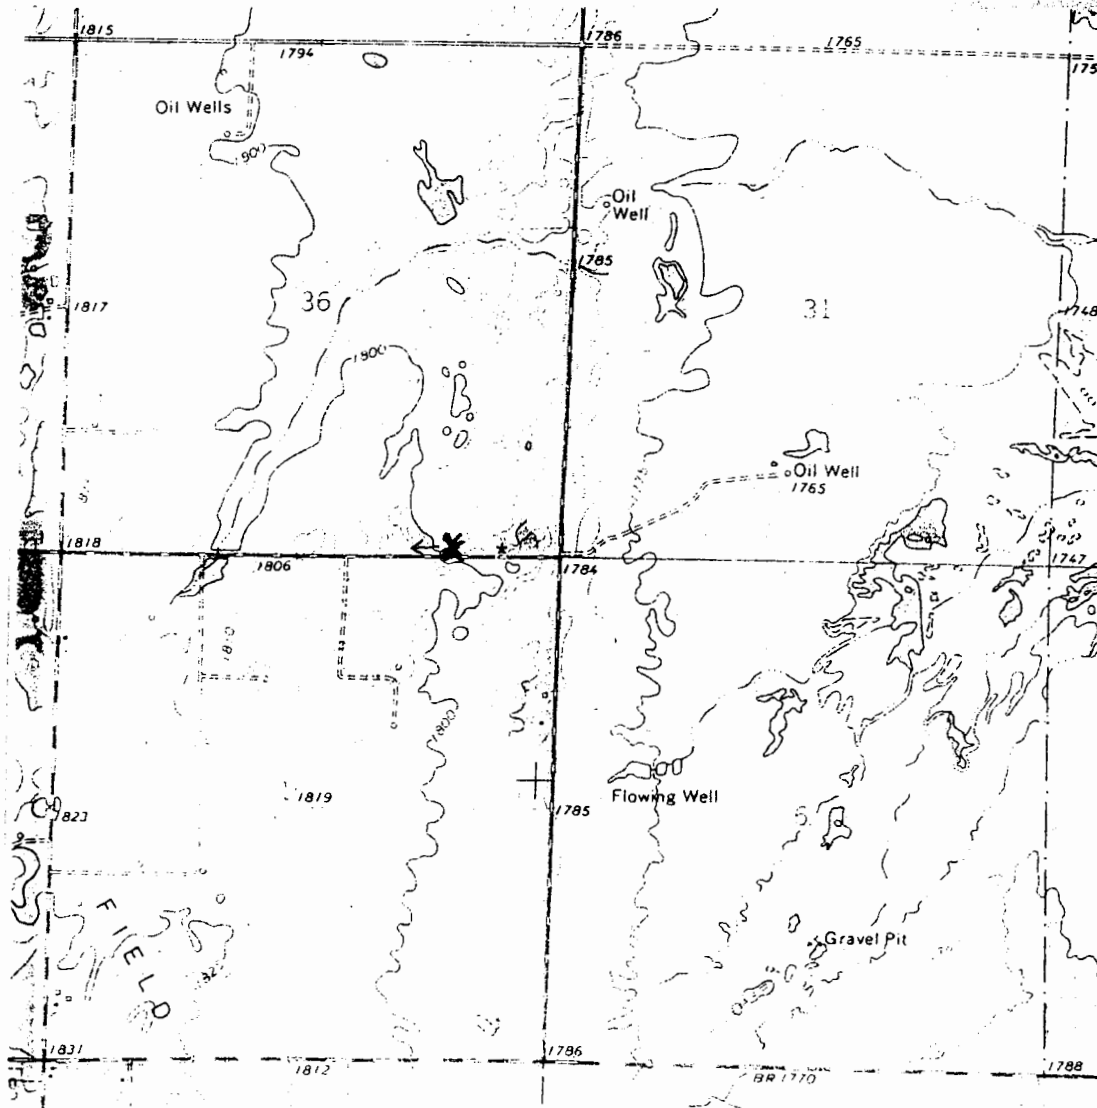

WELL LOCATION \*

\* correct site.