


1 LOCATION OF WATER WELL: Fraction SE 1/4 SE 1/4 SW 1/4 Section Number 31 Township Number T 21 S Range Number R 13 EW

Distance and direction from nearest town or city street address of well if located within city? First Street and Seward Avenue, Seward, Kansas

2 WATER WELL OWNER: J & R Service RR#, St. Address, Box #: P.O. Box 316 Board of Agriculture, Division of Water Resources City, State, ZIP Code: Seward, Kansas 67577 Application Number:

3 LOCATE WELL'S LOCATION WITH AN "X" IN SECTION BOX:

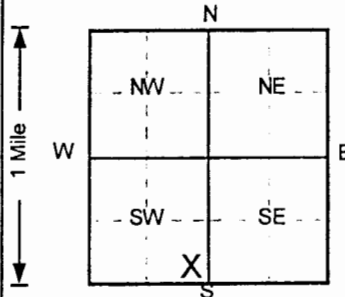

4 DEPTH OF COMPLETED WELL: 25 ft ELEVATION: 0 ft. WELL'S STATIC WATER LEVEL: .999 ft below land surface. Pump test data: Well water was NA ft after NA hours pumping. Est Yield NA gpm. Bore Hole Diameter NA in. to NA ft, and NA in. to NA ft. WELL WATER TO BE USED AS: 5 Public water supply, 8 Air conditioning, 11 Injection well, 12 Other (Specify below) Air Sparging. Was a chemical/bacteriological sample submitted? Yes No. Water Well Disinfected? Yes No.

5 TYPE OF BLANK CASING USED: 1 Steel, 2 PVC, 3 RMP (SR), 4 ABS, 5 Wrought iron, 6 Asbestos-Cement, 7 Fiberglass, 8 Concrete tile, 9 Other (specify below), 10 Asbestos-cement. Casing diameter 2 in. to 2 ft, Dia 4.8 in., weight lbs/ft. Wall thickness or gauge No. CASING JOINTS: Glued, Clamped, Welded, Threaded.

TYPE OF SCREEN OR PERFORATION MATERIAL: 1 Steel, 2 Brass, 3 Stainless steel, 4 Galvanized steel, 5 Fiberglass, 6 Concrete tile, 7 PVC, 8 RMP (SR), 9 ABS, 10 Asbestos-cement, 11 Other (specify), 12 None used (open hole).

SCREEN OR PERFORATION OPENINGS ARE: 1 Continuous slot, 2 Louvered shutter, 3 Mill slot, 4 Key punched, 5 Gauzed wrapped, 6 Wire wrapped, 7 Torch cut, 8 Saw cut, 9 Drilled holes, 10 Other (specify), 11 None (open hole).

SCREEN-PERFORATED INTERVALS: From 23 ft to 25 ft. GRAVEL PACK INTERVALS: From ft to ft.

6 GROUT MATERIAL: 1 Neat cement, 2 Cement grout, 3 Bentonite, 4 Other. Grout Intervals: From 0 ft to 25 ft. What is the nearest source of possible contamination: 1 Septic tank, 2 Sewer lines, 3 Watertight sewer lines, 4 Lateral lines, 5 Cess pool, 6 Seepage pit, 7 Pit privy, 8 Sewage lagoon, 9 Feedyard, 10 Livestock pens, 11 Fuel storage, 12 Fertilizer storage, 13 Insecticide storage, 14 Abandoned water well, 15 Oil well/Gas well, 16 Other (specify below). Direction from well? How many feet? 0.

Table with columns: FROM, TO, LITHOLOGIC LOG, FROM, TO, PLUGGING INTERVALS. Row 1: FROM, TO, Bentonite, FROM, TO, Bentonite. Row 2: FROM, TO, ASW-Plug, Tag #, FROM, TO, Project Name: J and R Service, FROM, TO, GeoCore # 355, #.

7 CONTRACTOR'S OR LANDOWNER'S CERTIFICATION: This water well was (1) constructed, (2) reconstructed, or (3) plugged under my jurisdiction and was completed on (mo/day/year) 7/23/97 and this record is true to the best of my knowledge and belief. Kansas Water Well Contractor's License No. 527. This Water Well Record was completed on (mo/day/yr) 9/10/97 under the business name of GeoCore Services, Inc. by (signature) Bob Roll.