

1 LOCATION OF WATER WELL:	Fraction	Section Number	Township Number	Range Number
County: Stafford	SE 1/4 SE 1/4 SW 1/4	31	T 21 S	R 13 EW


Distance and direction from nearest town or city street address of well if located within city?

First Street and Seward Avenue, Seward, KS

2 WATER WELL OWNER: **J & R Service**

RR#, St. Address, Box # : **P.O. Box 316** Board of Agriculture, Division of Water Resources

City, State, ZIP Code : **Seward, Kansas 67577** Application Number: _____

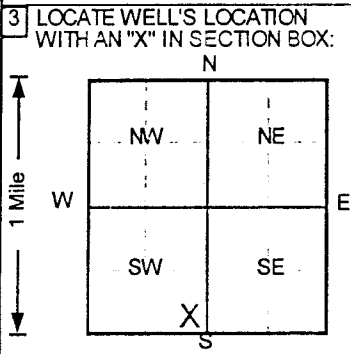

4 DEPTH OF COMPLETED WELL **23** ft. ELEVATION: **0**

Depth(s) Groundwater Encountered 1. **999** ft. 2. _____ ft. 3. _____ ft.

WELL'S STATIC WATER LEVEL **999** ft. below land surface measured on **mo/day/yr**

Pump test data: Well water was **NA** ft. after _____ hours pumping _____ gpm

Est. Yield **NA** gpm; Well water was _____ ft. after _____ hours pumping _____ gpm

Bore Hole Diameter _____ in. to _____ ft., and _____ in. to _____ ft.

WELL WATER TO BE USED AS: 5 Public water supply 8 Air conditioning 11 Injection well

1 Domestic 3 Feedlot 6 Oil field water supply 9 Dewatering (12) Other (Specify below) **Air Sparging Obser.**

2 Irrigation 4 Industrial 7 Lawn and garden only 10 Monitoring well

Was a chemical/bacteriological sample submitted to Department? Yes No ; If yes, mo/day/yr sample was submitted _____

Water Well Disinfected? Yes No

5 TYPE OF BLANK CASING USED:

1 Steel 3 RMP (SR) 5 Wrought iron 8 Concrete tile CASING JOINTS: Glued _____ Clamped _____

(2) PVC 4 ABS 6 Asbestos-Cement 9 Other (specify below) Welded _____

7 Fiberglass Threaded

Blank casing diameter **2** in. to _____ ft. Dia _____ in. to _____ ft. Dia _____ in. to _____ ft.

Casing height above land surface **-3** in., weight _____ lbs./ft. Wall thickness or gauge No. _____

TYPE OF SCREEN OR PERFORATION MATERIAL

1 Steel 3 Stainless steel 5 Fiberglass (7) PVC 10 Asbestos-cement

2 Brass 4 Galvanized steel 6 Concrete tile 8 RMP (SR) 11 Other (specify) _____

12 None used (open hole)

SCREEN OR PERFORATION OPENINGS ARE:

1 Continuous slot (3) Mill slot 5 Gauzed wrapped 8 Saw cut 11 None (open hole)

2 Louvered shutter 4 Key punched 6 Wire wrapped 9 Drilled holes

7 Torch cut 10 Other (specify) _____

SCREEN-PERFORATED INTERVALS: From **18** ft. to **23** ft., From _____ ft. to _____ ft.

From _____ ft. to _____ ft., From _____ ft. to _____ ft.

GRAVEL PACK INTERVALS: From _____ ft. to _____ ft., From _____ ft. to _____ ft.

From _____ ft. to _____ ft., From _____ ft. to _____ ft.

6 GROUT MATERIAL: 1 Neat cement 2 Cement grout (3) Bentonite 4 Other _____

Grout Intervals: From **0** ft. to **23** ft., From _____ ft. to _____ ft., From _____ ft. to _____ ft.

What is the nearest source of possible contamination:

1 Septic tank 4 Lateral lines 7 Pit privy 10 Livestock pens (14) Abandoned water well

2 Sewer lines 5 Cess pool 8 Sewage lagoon 11 Fuel storage 15 Oil well/Gas well

3 Watertight sewer lines 6 Seepage pit 9 Feedyard 12 Fertilizer storage 16 Other (specify below) _____

13 Insecticide storage _____

Direction from well? _____ How many feet? **0**

FROM	TO	LITHOLOGIC LOG	FROM	TO	PLUGGING INTERVALS
			0	23	Bentonite
					ASOW-1 Plug , Tag #
					Project Name: J and R Service
					GeoCore # 355 , #

7 CONTRACTOR'S OR LANDOWNER'S CERTIFICATION: This water well was (1) constructed, (2) reconstructed, or (3) plugged under my jurisdiction and was completed on (mo/day/year) **7/23/97** and this record is true to the best of my knowledge and belief.

Kansas Water Well Contractor's License No. **527** This Water Well Record was completed on (mo/day/yr) **9/10/97** under the business name of **GeoCore Services, Inc.** by (signature) **Dave Koll**