


1 LOCATION OF WATER WELL: County: <b>Stafford</b>	Fraction <b>NW ¼ NW ¼ NW ¼</b>	Section Number <b>22</b>	Township Number <b>T 21 S</b>	Range Number <b>R 13 EW</b>
--	-----------------------------------	-----------------------------	----------------------------------	--------------------------------

Distance and direction from nearest town or city street address of well if located within city?  
2½ N 2½ E of Seward, Ks.

2 WATER WELL OWNER: **Lee Seder**  
 RR#, St. Address, Box # : **5501 9th St. #73**  
 City, State, ZIP Code : **Great Bend, Ks. 67530**

Board of Agriculture, Division of Water Resources  
 Application Number: **SFWW 1543**

3 LOCATE WELL'S LOCATION WITH AN "X" IN SECTION BOX:

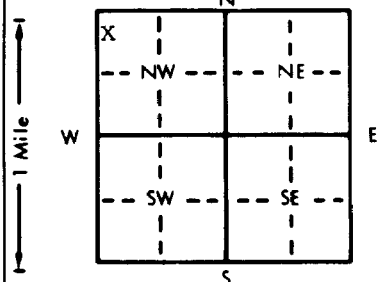

4 DEPTH OF COMPLETED WELL: **70** ft. ELEVATION:

Depth(s) Groundwater Encountered 1. . . . . ft. 2. . . . . ft. 3. . . . . ft.

WELL'S STATIC WATER LEVEL **15** . . . . . ft. below land surface measured on **mo/day/yr 5-18-00**

Pump test data: Well water was . . . . . ft. after . . . . . hours pumping . . . . . gpm

Est. Yield **NA** . . . . . gpm; Well water was . . . . . ft. after . . . . . hours pumping . . . . . gpm

Bore Hole Diameter: **9 7/8** . . . . . in. to **70** . . . . . ft., and . . . . . in. to . . . . . ft.

WELL WATER TO BE USED AS:

5 Public water supply	8 Air conditioning	11 Injection well
1 Domestic	3 Feedlot	6 Oil field water supply
2 Irrigation	4 Industrial	7 Lawn and garden only
		10 Monitoring well

Was a chemical/bacteriological sample submitted to Department? Yes . . . . . No **X** . . . . . ; If yes, mo/day/yr sample was submitted

Water Well Disinfected? Yes **HTH** No

5 TYPE OF BLANK CASING USED:

1 Steel	3 RMP (SR)	5 Wrought iron	8 Concrete tile	CASING JOINTS: Glued <b>X</b> . . . . . Clamped . . . . .
2 PVC	4 ABS	6 Asbestos-Cement	9 Other (specify below)	Welded . . . . .
		7 Fiberglass		Threaded . . . . .

Blank casing diameter . . . **5** . . . . . in. to . . . **50** . . . . . ft., Dia . . . . . in. to . . . . . ft., Dia . . . . . in. to . . . . . ft.

Casing height above land surface: **24** . . . . . in., weight **SDR 26** . . . . . lbs./ft. Wall thickness or gauge No. . . . .

TYPE OF SCREEN OR PERFORATION MATERIAL:

1 Steel	3 Stainless steel	5 Fiberglass	7 PVC	10 Asbestos-cement
2 Brass	4 Galvanized steel	6 Concrete tile	8 RMP (SR)	11 Other (specify)
			9 ABS	12 None used (open hole)

SCREEN OR PERFORATION OPENINGS ARE:

1 Continuous slot	3 Mill slot	5 Gauzed wrapped	8 Saw cut	11 None (open hole)
2 Louvered shutter	4 Key punched	6 Wire wrapped	9 Drilled holes	
		7 Torch cut	10 Other (specify)	

SCREEN-PERFORATED INTERVALS: From **50** . . . . . ft. to **70** . . . . . ft., From . . . . . ft. to . . . . . ft.

GRAVEL PACK INTERVALS: From **20** . . . . . ft. to **70** . . . . . ft., From . . . . . ft. to . . . . . ft.

6 GROUT MATERIAL: 1 Neat cement 2 Cement grout 3 Bentonite 4 Other **hole plug**

Grout Intervals: From **20** . . . . . ft. to **0** . . . . . ft., From . . . . . ft. to . . . . . ft., From . . . . . ft. to . . . . . ft.

What is the nearest source of possible contamination:

1 Septic tank	4 Lateral lines	7 Pit privy	10 Livestock pens	14 Abandoned water well
2 Sewer lines	5 Cess pool	8 Sewage lagoon	11 Fuel storage	15 Oil well/Gas well
3 Watertight sewer lines	6 Seepage pit	9 Feedyard	12 Fertilizer storage	16 Other (specify below)

Direction from well? **west** How many feet? **90**

FROM	TO	LITHOLOGIC LOG	FROM	TO	PLUGGING INTERVALS
0	3	Top soil sandy			
3	23	Gray, brown & white sandy clay			
23	26	Sandy gray clay			
26	29	Brown, white & gray clay			
29	43	Sand & gravel w/clay mixed			
43	50	Sand & gravel loose, medium			
50	52	Blue clay			
52	70	Sand & gravel-loose, medium			

7 CONTRACTOR'S OR LANDOWNER'S CERTIFICATION: This water well was (1) constructed, (2) reconstructed, or (3) plugged under my jurisdiction and was completed on (mo/day/year) **6-5-00** . . . . . and this record is true to the best of my knowledge and belief. Kansas Water Well Contractor's License No. **134** . . . . . This Water Well Record was completed on (mo/day/yr) **6-6-00** . . . . . under the business name of **Rosencrantz-Bemis** by (signature) *Tora Alife*

INSTRUCTIONS: Use typewriter or ball point pen. PLEASE PRESS FIRMLY and PRINT clearly. Please fill in blanks, underline or circle the correct answers. Send top three copies to Kansas Department of Health and Environment, Bureau of Water, Topeka, Kansas 66620-0001. Telephone: 913-296-5545. Send one to WATER WELL OWNER and retain one for your records.