


LOCATION OF WATER WELL: Fraction SW 1/4 SE 1/4 SE 1/4 Section Number 7 Township Number T 21 S Range Number R 13 EW

Distance and direction from nearest town or city street address of well if located within city?

3 1/2 North of Seward, KS

WATER WELL OWNER: American Warrior
 R#, St. Address, Box #: P.O. Box 399
 City, State, ZIP Code: Garden City, KS 67846
 Board of Agriculture, Division of Water Resources
 Application Number: 20010073 SFWW1866

LOCATE WELL'S LOCATION WITH AN "X" IN SECTION BOX: 4 DEPTH OF COMPLETED WELL: 65 ft. ELEVATION: ft.

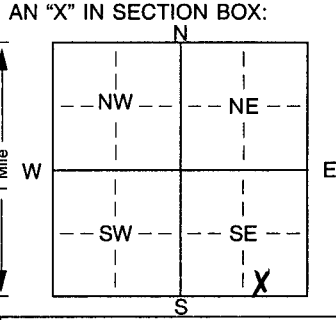

Depth(s) Groundwater Encountered 1. ft. 2. ft. 3. ft.
 WELL'S STATIC WATER LEVEL . . . 17. . . . ft. below land surface measured on mo/day/yr . . . 5-7-01
 Pump test data: Well water was ft. after hours pumping gpm
 Est. Yield . . . NA gpm: Well water was ft. after hours pumping gpm
 Bore Hole Diameter. . . 9 7/8 . . . in. to ft., and in. to ft.
 WELL WATER TO BE USED AS: 5 Public water supply 8 Air conditioning 11 Injection well
 1 Domestic 3 Feedlot 6 Oil field water supply 9 Dewatering 12 Other (Specify below)
 2 Irrigation 4 Industrial 7 Domestic (lawn & garden) 10 Monitoring well
 Was a chemical/bacteriological sample submitted to Department? Yes. No. . . . ; If yes, mo/day/yr sample was submitted
 Water Well Disinfected? Yes No

TYPE OF BLANK CASING USED: 5 Wrought iron 8 Concrete tile CASING JOINTS: Glued. . . . Clamped.
 1 Steel 3 RMP (SR) 6 Asbestos-Cement 9 Other (specify below) Welded
 2 PVC 4 ABS 7 Fiberglass Threaded.

Blank casing diameter . . . 5 1/2 . . . in. to . . . 45 . . . ft., Dia in. to ft., Dia in. to ft.
 Casing height above land surface. . . . 2' in., weight SDR-26 lbs./ft. Wall thickness or gauge No.

TYPE OF SCREEN OR PERFORATION MATERIAL: 7 PVC 10 Asbestos-cement
 1 Steel 3 Stainless steel 5 Fiberglass 8 RMP (SR) 11 Other (specify)
 2 Brass 4 Galvanized steel 6 Concrete tile 9 ABS 12 None used (open hole)

SCREEN OR PERFORATION OPENINGS ARE: 5 Gauzed wrapped 8 Saw cut 11 None (open hole)
 1 Continuous slot 3 Mill slot 6 Wire wrapped 9 Drilled holes
 2 Louvered shutter 4 Key punched 7 Torch cut 10 Other (specify) ft.

SCREEN-PERFORATED INTERVALS: From 65 ft. to 45 ft., From ft. to ft.
 From ft. to ft., From ft. to ft.
 GRAVEL PACK INTERVALS: From 65 ft. to 17 ft., From ft. to ft.
 From ft. to ft., From ft. to ft.


GROUT MATERIAL: 1 Neat cement 2 Cement grout 3 Bentonite 4 Other . . . hole plug
 Grout intervals: From 17 ft. to 0 ft., From ft. to ft., From ft. to ft.
 What is the nearest source of possible contamination: 10 Livestock pens 14 Abandoned water well
 1 Septic tank 4 Lateral lines 7 Pit privy 11 Fuel storage 15 Oil well/Gas well
 2 Sewer lines 5 Cess pool 8 Sewage lagoon 12 Fertilizer storage 16 Other (specify below)
 3 Watertight sewer lines 6 Seepage pit 9 Feedyard 13 Insecticide storage . . . oil well
 Direction from well? west How many feet? 500

FROM	TO	LITHOLOGIC LOG	FROM	TO	PLUGGING INTERVALS
0	3	Sandy top soil			
3	8	Fine sand			
8	16	Brown & gray clay			
16	39	Fine sand & clay mixed			
39	47	Sand & gravel with clay streaks			
47	65	Sand & gravel medium, clean, tight			

CONTRACTOR'S OR LANDOWNER'S CERTIFICATION: This water well was (1) constructed, (2) reconstructed, or (3) plugged under my jurisdiction and was completed on (mo/day/year) 5-7-01 and this record is true to the best of my knowledge and belief. Kansas Water Well Contractor's Licence No. . . . 134 This Water Well Record was completed on (mo/day/yr) . . . 5-25-01
 Under the business name of Rosenkrantz-Bemis by (signature) *India Hodson*