


1] LOCATION OF WATER WELL: County: Stafford	Fraction N/C 1/4 NE 1/4 NE 1/4	Section Number 19	Township Number T 21 S	Range Number R 13 W
---	--	-----------------------------	----------------------------------	--

Distance and direction from nearest town or city street address of well if located within city?

4 3/4 north, 1/4 east of Seward, KS

2] WATER WELL OWNER: **American Warrior Inc.** SFWW2080
 RR#, St. Address, Box # : **P.O. Box 399** Board of Agriculture, Division of Water Resources
 City, State, ZIP Code : **Garden City, KS 67846-8399** Application Number: **20010229**

3] LOCATE WELL'S LOCATION WITH AN "X" IN SECTION BOX: 4] DEPTH OF COMPLETED WELL: **.75** ft. ELEVATION:

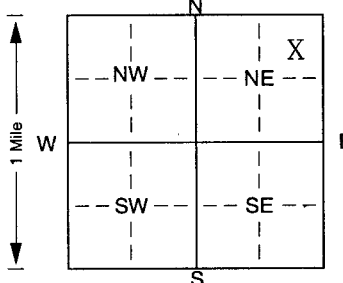

Depth(s) Groundwater Encountered **1** ft. 2. ft. 3. ft.
 WELL'S STATIC WATER LEVEL **13** ft. below land surface measured on mo/day/yr **10-26-01**
 Pump test data: Well water was ft. after hours pumping gpm
 Est. Yield **NA** gpm: Well water was ft. after hours pumping gpm
 Bore Hole Diameter. **9 7/8** in. to **75** ft., and in. to ft.
 WELL WATER TO BE USED AS: 5 Public water supply 8 Air conditioning 11 Injection well
 1 Domestic 3 Feedlot 6 Oil field water supply 9 Dewatering 12 Other (Specify below)
 2 Irrigation 4 Industrial 7 Domestic (lawn & garden) 10 Monitoring well

5] TYPE OF BLANK CASING USED: 5 Wrought iron 8 Concrete tile CASING JOINTS: Glued. Clamped.
 1 Steel 3 RMP (SR) 6 Asbestos-Cement 9 Other (specify below) Welded

Blank casing diameter **5** in. to **55** ft., Dia in. to ft., Dia in. to ft.
 Casing height above land surface **24** in., weight **SDR-26** lbs./ft. Wall thickness or gauge No.

TYPE OF SCREEN OR PERFORATION MATERIAL: 7 PVC 10 Asbestos-cement
 1 Steel 3 Stainless steel 5 Fiberglass 8 RMP (SR) 11 Other (specify)

SCREEN OR PERFORATION OPENINGS ARE: 5 Gauzed wrapped 8 Saw cut 11 None (open hole)
 1 Continuous slot 3 Mill slot 6 Wire wrapped 9 Drilled holes
 2 Louvered shutter 4 Key punched 7 Torch cut 10 Other (specify)

SCREEN-PERFORATED INTERVALS: From **75** ft. to **55** ft., From ft. to ft.
 GRAVEL PACK INTERVALS: From **75** ft. to **13** ft., From ft. to ft.

6] GROUT MATERIAL: 1 Neat cement 2 Cement grout 3 Bentonite 4 Other **hole plug**
 Grout Intervals: From **13** ft. to **0** ft., From ft. to ft., From ft. to ft.

What is the nearest source of possible contamination:
 1 Septic tank 4 Lateral lines 7 Pit privy 10 Livestock pens 14 Abandoned water well
 2 Sewer lines 5 Cess pool 8 Sewage lagoon 11 Fuel storage 15 Oil well/Gas well
 3 Watertight sewer lines 6 Seepage pit 9 Feedyard 12 Fertilizer storage 16 Other (specify below)
 None

Direction from well? How many feet?

FROM	TO	LITHOLOGIC LOG	FROM	TO	PLUGGING INTERVALS
0	2	top soil			
2	11	gray clay			
11	15	sandy brown clay			
15	32	fine sand and tan clay mix			
32	41	tan, gray, and white clay			
41	75	sand and gravel clean, medium, loose			

7] CONTRACTOR'S OR LANDOWNER'S CERTIFICATION: This water well was (1) constructed, (2) reconstructed, or (3) plugged under my jurisdiction and was completed on (mo/day/year) **10-26-01** and this record is true to the best of my knowledge and belief. Kansas Water Well Contractor's Licence No. **134** This Water Well Record was completed on (mo/day/yr) **10-31-01** under the business name of **Rosencrantz-Bemis** by (signature) *Freddie Hudson*