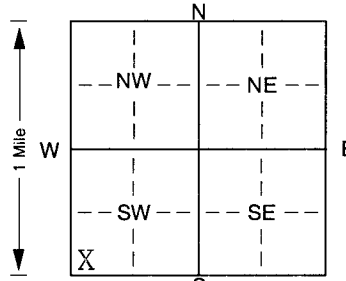


1] LOCATION OF WATER WELL: County: <u>Stafford</u>	Fraction <u>SW 1/4 SW 1/4 SW 1/4</u>	Section Number <u>15</u>	Township Number <u>T 21 S</u>	Range Number <u>R 13 EW</u>
---	---	-----------------------------	----------------------------------	--------------------------------

Distance and direction from nearest town or city street address of well if located within city?
2 1/2 east, 3 north of Seward, KS

2] WATER WELL OWNER: American Warrior, Inc.
 RR#, St. Address, Box # : P.O. Box 399
 City, State, ZIP Code : Garden City, KS 67846
 Board of Agriculture, Division of Water Resources
 Application Number: 20020041

3] LOCATE WELL'S LOCATION WITH AN "X" IN SECTION BOX: 	4] DEPTH OF COMPLETED WELL: <u>54</u> ft. ELEVATION: Depth(s) Groundwater Encountered 1. ft. 2. ft. 3. ft. WELL'S STATIC WATER LEVEL <u>14</u> ft. below land surface measured on <u>mo/day/yr</u> <u>3-18-02</u> Pump test data: Well water was ft. after hours pumping gpm Est. Yield <u>NA</u> gpm: Well water was ft. after hours pumping gpm Bore Hole Diameter <u>9.7/8</u> in. to <u>54</u> ft., and in. to ft. WELL WATER TO BE USED AS: 5 Public water supply 8 Air conditioning 11 Injection well 1 Domestic 3 Feedlot 6 Oil field water supply 9 Dewatering 12 Other (Specify below) 2 Irrigation 4 Industrial 7 Domestic (lawn & garden) 10 Monitoring well Was a chemical/bacteriological sample submitted to Department? Yes. No. <u>X</u> ; If yes, mo/day/yr sample was submitted Water Well Disinfected? Yes No <u>X</u>
---	---

5] TYPE OF BLANK CASING USED:
 1 Steel 3 RMP (SR) 5 Wrought iron 8 Concrete tile CASING JOINTS: Glued. X Clamped.
 2 PVC 4 ABS 6 Asbestos-Cement 9 Other (specify below) Welded.
 7 Fiberglass Threaded.
 Blank casing diameter 5 in. to 32 ft., Dia. in. to ft., Dia. in. to ft.
 Casing height above land surface 24 in., weight SDR-26 lbs./ft. Wall thickness or gauge No.
 TYPE OF SCREEN OR PERFORATION MATERIAL:
 1 Steel 3 Stainless steel 5 Fiberglass 7 PVC 10 Asbestos-cement
 2 Brass 4 Galvanized steel 6 Concrete tile 8 RMP (SR) 11 Other (specify)
 9 ABS 12 None used (open hole)
 SCREEN OR PERFORATION OPENINGS ARE:
 1 Continuous slot 3 Mill slot 5 Gauzed wrapped 8 Saw cut 11 None (open hole)
 2 Louvered shutter 4 Key punched 6 Wire wrapped 9 Drilled holes
 7 Torch cut 10 Other (specify) ft.
 SCREEN-PERFORATED INTERVALS: From 52 ft. to 32 ft., From ft. to ft.
 From ft. to ft., From ft. to ft.
 GRAVEL PACK INTERVALS: From 52 ft. to 14 ft., From ft. to ft.
 From ft. to ft., From ft. to ft.

6] GROUT MATERIAL: 1 Neat cement 2 Cement grout 3 Bentonite 4 Other hole plug
 Grout Intervals: From 14 ft. to 0 ft., From ft. to ft., From ft. to ft.
 What is the nearest source of possible contamination:
 1 Septic tank 4 Lateral lines 7 Pit privy 10 Livestock pens 14 Abandoned water well
 2 Sewer lines 5 Cess pool 8 Sewage lagoon 11 Fuel storage 15 Oil well/Gas well
 3 Watertight sewer lines 6 Seepage pit 9 Feedyard 12 Fertilizer storage 16 Other (specify below)
 13 Insecticide storage None
 Direction from well? How many feet?

FROM	TO	LITHOLOGIC LOG	FROM	TO	PLUGGING INTERVALS
0	4	sandy top soil			
4	14	sandy brown clay			
14	18	gray clay			
18	27	tan, gray, and white clay with gravel streaks			
27	34	sand and gravel, clean, small, loose, clay streaks			
34	41	sand and gravel, clean, small, loose			
41	44	clay and gravel mix			
44	54	sand and gravel, clean, small, loose, caliche hard			

7] CONTRACTOR'S OR LANDOWNER'S CERTIFICATION: This water well was (1) constructed, (2) reconstructed, or (3) plugged under my jurisdiction and was completed on (mo/day/year) 3-18-02 and this record is true to the best of my knowledge and belief. Kansas Water Well Contractor's Licence No. 134. This Water Well Record was completed on (mo/day/yr) 3-28-02 under the business name of Rosencrantz-Bemis by (signature) Media Hagan