


1 LOCATION OF WATER WELL:	Fraction	Section Number	Township Number	Range Number
County: <u>Stafford</u>	<u>SW 1/4 SE 1/4 SE 1/4</u>	<u>17</u>	<u>T 21 S</u>	<u>R 13</u> <input checked="" type="checkbox"/> <u>W</u>

Distance and direction from nearest town or city street address of well if located within city?
2 3/4 north, 1 east of Seward, KS

2 WATER WELL OWNER: American Warrior
 RR#, St. Address, Box # : P.O. Box 399
 City, State, ZIP Code : Garden City, KS 67846
 Board of Agriculture, Division of Water Resources
 Application Number: 20020034

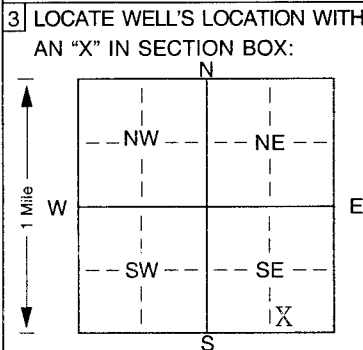

4 DEPTH OF COMPLETED WELL: 57 ft. ELEVATION:

Depth(s) Groundwater Encountered 1. ft. 2. ft. 3. ft.

WELL'S STATIC WATER LEVEL 12 ft. below land surface measured on mo/day/yr 2-27-02

Pump test data: Well water was ft. after hours pumping gpm

Est. Yield NA gpm; Well water was ft. after hours pumping gpm

Bore Hole Diameter: 9 7/8 in. to 57 ft., and in. to ft.

WELL WATER TO BE USED AS:

5 Public water supply	8 Air conditioning	11 Injection well
1 Domestic	3 Feedlot	6 Oil field water supply
2 Irrigation	4 Industrial	7 Domestic (lawn & garden)
		10 Monitoring well
		9 Dewatering
		12 Other (Specify below)

Was a chemical/bacteriological sample submitted to Department? Yes. No. ; If yes, mo/day/yr sample was submitted

Water Well Disinfected? Yes No

5 TYPE OF BLANK CASING USED:

1 Steel	3 RMP (SR)	6 Asbestos-Cement	9 Other (specify below)	CASING JOINTS: Glued. <input checked="" type="checkbox"/> Clamped.
2 PVC	4 ABS	7 Fiberglass		Welded
				Threaded

Blank casing diameter 5 in. to 37 ft., Dia in. to ft., Dia in. to ft.

Casing height above land surface 24 in., weight SDR-26 lbs./ft. Wall thickness or gauge No.

TYPE OF SCREEN OR PERFORATION MATERIAL:

1 Steel	3 Stainless steel	5 Fiberglass	8 RMP (SR)	10 Asbestos-cement
2 Brass	4 Galvanized steel	6 Concrete tile	9 ABS	11 Other (specify)
				12 None used (open hole)

SCREEN OR PERFORATION OPENINGS ARE:

1 Continuous slot	3 Mill slot	5 Gauzed wrapped	8 Saw cut	11 None (open hole)
2 Louvered shutter	4 Key punched	6 Wire wrapped	9 Drilled holes	
		7 Torch cut	10 Other (specify)	

SCREEN-PERFORATED INTERVALS: From 37 ft. to 57 ft., From ft. to ft.

GRAVEL PACK INTERVALS: From 57 ft. to 12 ft., From ft. to ft.

6 GROUT MATERIAL: 1 Neat cement 2 Cement grout 3 Bentonite 4 Other hole plug

Grout Intervals: From 12 ft. to 0 ft., From ft. to ft., From ft. to ft.

What is the nearest source of possible contamination:

1 Septic tank	4 Lateral lines	7 Pit privy	10 Livestock pens	14 Abandoned water well
2 Sewer lines	5 Cess pool	8 Sewage lagoon	11 Fuel storage	15 Oil well/Gas well
3 Watertight sewer lines	6 Seepage pit	9 Feedyard	12 Fertilizer storage	16 Other (specify below)
			13 Insecticide storage	<u>None</u>

Direction from well? How many feet?

FROM	TO	LITHOLOGIC LOG	FROM	TO	PLUGGING INTERVALS
0	3	top soil			
3	7	brown clay			
7	11	clay and gravel mixed			
11	57	sand and gravel, clean, medium, loose			

7 CONTRACTOR'S OR LANDOWNER'S CERTIFICATION: This water well was (1) constructed, (2) reconstructed, or (3) plugged under my jurisdiction and was completed on (mo/day/year) 2-27-02 and this record is true to the best of my knowledge and belief. Kansas Water Well Contractor's Licence No. 134 This Water Well Record was completed on (mo/day/yr) 3-21-02 under the business name of Rosenkrantz-Bemis by (signature) Media Hedson