


<b>1</b> LOCATION OF WATER WELL:	Fraction	Section	Number	Township	Number	Range	Number
County: <b>Stafford</b>	<b>NE 1/4 SW 1/4 NW 1/4</b>	<b>29</b>		<b>T</b>	<b>21</b>	<b>S</b>	<b>R 13 E</b> <span style="border: 1px solid black; border-radius: 50%; padding: 2px;">W</span>

Distance and direction from nearest town or city street address of well if located within city?  
Approximately 3/4 mile east and 1 3/4 miles north of Seward

**2** WATER WELL OWNER: **Rama Operating Co., Inc.**  
 RR#, St. Address, Box # **P.O. Box 159** Board of Agriculture, Division of Water Resources  
 City, State, ZIP Code **Stafford, KS 67578** Application Number: \_\_\_\_\_

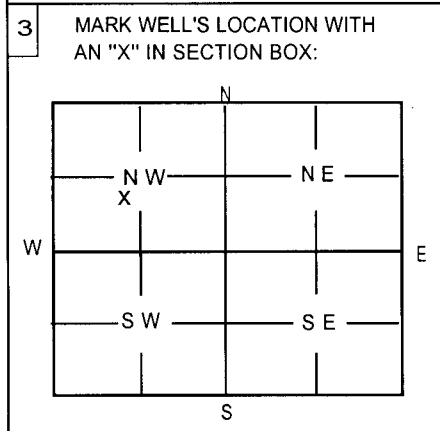

**4** DEPTH OF WELL 85 ft  
 WELL'S STATIC WATER LEVEL 15 ft.  
 WELL WAS USED AS:

1 Domestic	5 Public Water Supply	9 Dewatering
2 Irrigation	6 Oil Field Water Supply	10 Monitoring Well
3 Feedlot	7 Domestic (Lawn & Garden)	11 Injection Well
4 Industrial	8 Air Conditioning	12 Other

Was a chemical / bacteriological sample submitted to Department? Yes \_\_\_\_\_ No   
 If yes, mo/day/yr sample was submitted \_\_\_\_\_  
 Water Well Disinfected: Yes  No \_\_\_\_\_

**5** TYPE OF BLANK CASING USED:

<input checked="" type="radio"/> 1 Steel	3 RMP (SR)	5 Wrought	7 Fiberglass	9 Other (Specify below)
2 PVC	4 ABS	6 Asbestos-Cement	8 Concrete Tile	

Blank casing diameter 8 5/8 in. Was casing pulled? Yes \_\_\_\_\_ No  If yes, how much Cut off  
 Casing height above or  below land surface 36 in.

**6** GROUT PLUG MATERIAL: 1 Neat Cement 2 Cement grout 3 Bentonite 4 Other Bentonite Holeplug  
 Grout Plug Intervals: From \_\_\_\_\_ ft. to \_\_\_\_\_ ft., From \_\_\_\_\_ ft. to \_\_\_\_\_ ft. From 44 ft. to 3 ft.  
 What is the nearest source of possible contamination:

1 Septic tank	6 Seepage pit	11 Fuel storage	16 Other (specify below)
2 Sewer lines	7 Pit privy	12 Fertilizer storage	
3 Watertight sewer lines	8 Sewage lagoon	13 Insecticide storage	<u>Oilfield Tank Batteries</u>
4 Lateral lines	9 Feedyard	14 Abandoned water well	
5 Cess Pool	10 Livestock pens	15 Oil well/Gas well	

Direction from well? West How many feet? 10

FROM	TO	PLUGGING MATERIALS
85	44	Chlorinated Sand
44	3	Bentonite Holeplug
3	0	Compacted Soil

**7** CONTRACTOR'S OR LANDOWNER'S CERTIFICATION: This water well was plugged under my jurisdiction and was completed on (mo/day/year) 10-25-02 and this record is true to the best of my knowledge and belief. Kansas Water Well Contractor's License No. 185 This Water Well Record was completed on (mo/day/year) 10-28-02 under the business name of Clarke Well & Equipment, Inc.  
 by (signature) *David W. Clarke*

INSTRUCTIONS: Use typewriter or ball point pen. Please press firmly and print clearly. Please fill in blanks, underline or circle the correct answers. Send top three copies to Kansas Department of Health & Environment, Bureau of Water, Topeka, Kansas 66620-0001. Telephone: 785/296-3565. Send one to Water Well Owner and retain one for your records.