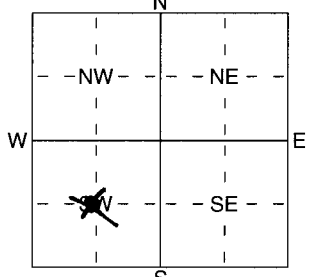


1 LOCATION OF WATER WELL: Fraction Near 1/4 Centers, SW 1/4 Section Number 24 Township Number T 21 S Range Number R 13 E/W
 County: Stafford

Distance and direction from nearest town or city street address of well if located within city?
2-1/4 miles North & 4 miles East of Seward, Ks.

2 WATER WELL OWNER: Leo Hall
 RR#, St. Address, Box # : Rt 2 Box 40 Board of Agriculture, Division of Water Resources
 City, State, ZIP Code : Great Bend, Ks. 67530 Application Number:

3 LOCATE WELL'S LOCATION WITH AN "X" IN SECTION BOX:

 4 DEPTH OF COMPLETED WELL 202 ft. ELEVATION:
 Depth(s) Groundwater Encountered 1 ft. 2 ft. 3 5/10/05 ft.
 WELL'S STATIC WATER LEVEL 18 ft. below land surface measured on mo/day/yr 5/10/05
 Pump test data: Well water was ft. after hours pumping gpm
 Est. Yield 50 gpm: Well water was ft. after hours pumping gpm
 WELL WATER TO BE USED AS:
 1 Domestic 3 Feedlot 6 Oil field water supply 8 Air conditioning 11 Injection well
 2 Irrigation 4 Industrial 7 Domestic (lawn & garden) Monitoring well 12 Other (Specify below)
 Was a chemical/bacteriological sample submitted to Department? Yes No ; If yes, mo/day/yr sample was submitted
 Water Well Disinfected? Yes No

5 TYPE OF BLANK CASING USED:
 1 Steel 3 RMP (SR) 5 Wrought iron 8 Concrete tile CASING JOINTS: Glued Clamped
 PVC 4 ABS 6 Asbestos-Cement 9 Other (specify below) Welded
 7 Fiberglass Threaded
 Blank casing diameter 3 in. to 197 ft. Dia 1.5 in. to ft. Dia in. to ft.
 Casing height above land surface 24 in., weight 1.5 lbs./ft. Wall thickness or gauge No. .165
 TYPE OF SCREEN OR PERFORATION MATERIAL:
 1 Steel 3 Stainless Steel 5 Fiberglass PVC 10 Asbestos-Cement
 2 Brass 4 Galvanized Steel 6 Concrete tile 8 RMP (SR) 11 Other (Specify)
 9 ABS 12 None used (open hole)
 SCREEN OR PERFORATION OPENINGS ARE:
 1 Continuous slot Mill slot 5 Gauzed wrapped 8 Saw cut 11 None (open hole)
 2 Louvered shutter 4 Key punched 6 Wire wrapped 9 Drilled holes
 7 Torch cut 10 Other (specify) ft.
 SCREEN-PERFORATED INTERVALS: From 197 ft. to 202 ft., From ft. to ft.
 GRAVEL PACK INTERVALS: From 180 ft. to 202 ft., From ft. to ft.

6 GROUT MATERIAL: 1 Neat cement Cement grout Bentonite 4 Other
 Grout Intervals: From 0 ft. to 20 bent ft., From 20 ft. to 180 conc ft., From ft. to ft.
 What is the nearest source of possible contamination: None within 1/4 mile
 1 Septic tank 4 Lateral lines 7 Pit privy 10 Livestock pens 14 Abandoned water well
 2 Sewer lines 5 Cess pool 8 Sewage lagoon 11 Fuel storage 15 Oil well/Gas well
 3 Watertight sewer lines 6 Seepage pit 9 Feedyard 12 Fertilizer storage 16 Other (specify below)
 13 Insecticide storage
 Direction from well? How many feet?

FROM	TO	LITHOLOGIC LOG	FROM	TO	PLUGGING INTERVALS
0	11	Clay, Brown, Sandy			
11	18	Clay, Tan, Sandy			
18	22.5	Sand & Gravel			
22.5	30	Clay, Sandy, Tan			
30	73	Sand, Fine to Coarse			
73	74	Clay, sandy, brown			
74	126	Sand, Fine to Coarse			
126	140	Sand, Fine, tight			
140	175	Sand, Fine to Coarse, Clay streaks			
175	200	Sand, Fine to Coarse, dark			
200	207	Clay, gray			
207	220	Shale, dark brown			

7 CONTRACTOR'S OR LANDOWNER'S CERTIFICATION: This water well was (1) constructed, (2) reconstructed, or (3) plugged under my jurisdiction and was completed on (mo/day/year) 5/10/05 and this record is true to the best of my knowledge and belief. Kansas Water Well Contractor's Licence No 138 This Water Well Record was completed on (mo/day/yr) 5/25/05 under the business name of Peterson Irrigation, Inc. by (signature) Mike Peterson