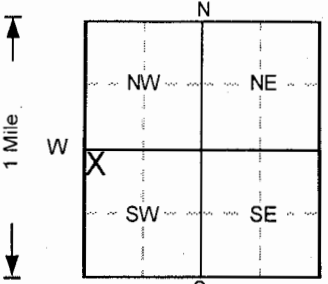


1 LOCATION OF WATER WELL: County: **Stafford** Fraction: NW ¼ NW ¼ SW ¼ Section Number: **22** Township Number: T **21** S Range Number: R **13** E/W **W**

Distance and direction from nearest town or city street address of well if located within city?
2 mi. E and 2 mi. N of Seward, Kansas

2 WATER WELL OWNER: **KDHE**
 RR#, St. Address, Box # : **1000 SW Jackson St., Suite 410**
 City, State, ZIP Code : **Topeka, KS 66612-1367**
 Board of Agriculture, Division of Water Resources
 Application Number:

3 LOCATE WELL'S LOCATION WITH AN "X" IN SECTION BOX:

 4 DEPTH OF COMPLETED WELL: **22** ft. ELEVATION: **1884.45**
 Depth(s) Groundwater Encountered 1. ft. 2. ft. 3. ft.
 WELL'S STATIC WATER LEVEL . . . **14.68** ft. below land surface measured on **mo/day/yr** **3/8/2005**
 Pump test data: Well water was **NA** ft. after hours pumping gpm
 Est. Yield . . **NA** gpm: Well water was ft. after hours pumping gpm
 Bore Hole Diameter . . **10.25** in. to **22** ft., and in. to ft.
 WELL WATER TO BE USED AS: 5 Public water supply 8 Air conditioning 11 Injection well
 1 Domestic 3 Feedlot 6 Oil field water supply 9 Dewatering 12 Other (Specify below)
 2 Irrigation 4 Industrial 7 Lawn and garden only **10** Monitoring well
 Was a chemical/bacteriological sample submitted to Department? Yes.....No ; If yes, mo/day/yr sample was submitted
 Water Well Disinfected? Yes No

5 TYPE OF BLANK CASING USED: 5 Wrought iron 8 Concrete tile CASING JOINTS: Glued Clamped
 1 Steel 3 RMP (SR) 6 Asbestos-Cement 9 Other (specify below) Welded
 2 PVC 4 ABS 7 Fiberglass Threaded.
 Blank casing diameter **4** in. to **12** ft., Dia in. to ft., Dia in. to ft.
 Casing height above land surface **-10.56** in., weight lbs./ft. Wall thickness or gauge No. **Sch. 40**
 TYPE OF SCREEN OR PERFORATION MATERIAL 7 PVC 10 Asbestos-cement
 1 Steel 3 Stainless steel 5 Fiberglass 8 RMP (SR) 11 Other (specify)
 2 Brass 4 Galvanized steel 6 Concrete tile 9 ABS 12 None used (open hole)
 SCREEN OR PERFORATION OPENINGS ARE: 5 Gauzed wrapped 8 Saw cut 11 None (open hole)
 1 Continuous slot 3 Mill slot 6 Wire wrapped 9 Drilled holes
 2 Louvered shutter 4 Key punched 7 Torch cut 10 Other (specify)
 SCREEN-PERFORATED INTERVALS: From **12** ft. to **22** ft., From ft. to ft.
 From ft. to ft., From ft. to ft.
 GRAVEL PACK INTERVALS: From **8** ft. to **22** ft., From ft. to ft.
 From ft. to ft., From ft. to ft.

6 GROUT MATERIAL: 1 Neat cement 2 Cement grout 3 Bentonite 4 Other **Concrete**
 Grout Intervals: From **0** ft. to **3** ft., From **3** ft. to **8** ft., From ft. to ft.
 What is the nearest source of possible contamination:
 1 Septic tank 4 Lateral lines 7 Pit privy 10 Livestock pens 14 Abandoned water well
 2 Sewer lines 5 Cess pool 8 Sewage lagoon 11 Fuel storage 15 Oil well/Gas well
 3 Watertight sewer lines 6 Seepage pit 9 Feedyard 12 Fertilizer storage 16 Other (specify below)
 13 Insecticide storage
 Direction from well? How many feet?

FROM	TO	LITHOLOGIC LOG	FROM	TO	PLUGGING INTERVALS
0	0.5	Asphalt,			
0.5	2	Sand (vf-c), tr. silt, v. Dark Gray			
2	3	Clay, silty, tr. to some sand, v. stiff, Brown			
3	8	Sand (vf-m), tr. silt and clay, Grayish Brown			
8	11	Sand (vf-m), some silt and clay, Pale Brown			
11	13	Sand (vf-m), tr. silt, Lt. Yellowish Brown			
13	19	Sand (vf-m), some silt and clay, Lt. Yellowish			
19	22	Sand (vf-f) and clay, tr. plastic, Lt. Brownish			
					MW4, Flushmount
					Project Name: BM - Stafford Co.
					GeoCore # 1214, #

7 CONTRACTOR'S OR LANDOWNER'S CERTIFICATION: This water well was (1) constructed, (2) reconstructed, or (3) plugged under my jurisdiction and was completed on (mo/day/year) **2/24/2005** and this record is true to the best of my knowledge and belief.
 Kansas Water Well Contractor's License No. **527** This Water Well Record was completed on (mo/day/yr) **10/21/2005**
 under the business name of **GeoCore, Inc.** by (signature) *Don Bobb*