

WATER WELL RECORD

Form WWC-5


Division of Water Resources App. No.

20100261

1 LOCATION OF WATER WELL: County: Stafford	Fraction ¼ SE ¼ NW ¼ SE ¼	Section Number 33	Township No. T 21 S	Range Number R 13 <input type="checkbox"/> E <input checked="" type="checkbox"/> W
---	-------------------------------------	-----------------------------	-------------------------------	--

Street/Rural Address of Well Location; if unknown, distance & direction from nearest town or intersection: If at owner's address, check here <input type="checkbox"/> 1 1/2E of Seward, KS	Global Positioning System (GPS) information: Latitude: (in decimal degrees) Longitude: (in decimal degrees) Elevation: Datum: <input type="checkbox"/> WGS 84, <input type="checkbox"/> NAD 83, <input type="checkbox"/> NAD 27 Collection Method: <input type="checkbox"/> GPS unit (Make/Model:) <input type="checkbox"/> Digital Map/Photo, <input type="checkbox"/> Topographic Map, <input type="checkbox"/> Land Survey Est. Accuracy: <input type="checkbox"/> <3 m, <input type="checkbox"/> 3-5 m, <input type="checkbox"/> 5-15 m, <input type="checkbox"/> >15 m
--	--

2 WATER WELL OWNER: John DeWeese RR#, Street Address, Box #: 1500 Broadway City, State, ZIP Code : Great Bend, KS 67530	
---	--

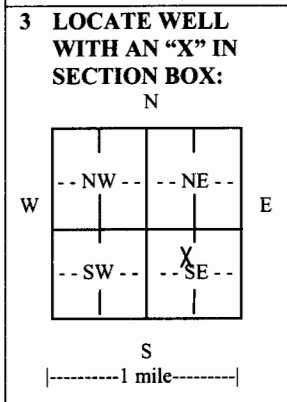

4 DEPTH OF COMPLETED WELL **94** ft.

Depth(s) Groundwater Encountered (1).....**14**..... ft. (2)..... ft. (3)..... ft.

WELL'S STATIC WATER LEVEL.....**14**..... ft. below land surface measured on mo/day/yr.....**06/25/10**.....

Pump test data: Well water was.....ft. after..... hours pumping..... gpm

EST. YIELD.....**80**.....gpm. Well water was.....ft. after..... hours pumping..... gpm

Bore Hole Diameterin. toft., andin. toft.

WELL WATER TO BE USED AS: Public water supply Geothermal Injection well
 Domestic Feedlot Oil field water supply Dewatering Other (Specify below)
 Irrigation Industrial Domestic-lawn & garden Monitoring well

Was a chemical/bacteriological sample submitted to Department? Yes No

If yes, mo/day/yr sample was submitted.....

Water well disinfected? Yes No

5 TYPE OF CASING USED: Steel PVC Other

CASING JOINTS: Glued Clamped Welded Threaded

Casing diameter**5**..... in. to**54**..... ft., Diameter in. to ft., Diameter in. to ft.

Casing height above land surface.....**12**..... in., Weight **.28**.....lbs./ft., Wall thickness or gauge No.**Sch. 40**.....

TYPE OF SCREEN OR PERFORATION MATERIAL:
 Steel Stainless Steel PVC Other (Specify)
 Brass Galvanized Steel None used (open hole)

SCREEN OR PERFORATION OPENINGS ARE:
 Continuous slot Mill slot Gauze wrapped Torch cut Drilled holes None (open hole)
 Louvered shutter Key punched Wire wrapped Saw cut Other (specify)

SCREEN-PERFORATED INTERVALS: From.....**54**..... ft. to**94**..... ft., From ft. to ft.
 From..... ft. to ft., From ft. to ft.

GRAVEL PACK INTERVALS: From.....**23**..... ft. to**94**..... ft., From ft. to ft.
 From..... ft. to ft., From ft. to ft.

6 GROUT MATERIAL: Neat cement Cement grout Bentonite Other

Grout Intervals: From.....**0**..... ft. to**23**..... ft., From ft. to ft., From ft. to ft.

What is the nearest source of possible contamination:
 Septic tank Lateral lines Pit privy Livestock pens Insecticide storage Other (specify below)
 Sewer lines Cesspool Sewage lagoon Fuel storage Abandoned water well
 Watertight sewer lines Seepage pit Feedyard Fertilizer storage Oil well/gas well

Direction from well**West**..... Distance from well**115**.....

FROM	TO	LITHOLOGIC LOG	FROM	TO	LITHO. LOG (cont.) or PLUGGING INTERVALS
0	3	top soil			
3	14	clay			Gates B#1
14	19	sand and gravel			
19	45	sandy clay			Charter Energy
45	94	sand and gravel with clay streaks			P. O. Box 252
					Great Bend, KS 67530

7 CONTRACTOR'S OR LANDOWNER'S CERTIFICATION: This water well was constructed, reconstructed, or plugged under my jurisdiction and was completed on (mo/day/year) **6/25/10**..... and this record is true to the best of my knowledge and belief.

Kansas Water Well Contractor's License No.**186**..... This Water Well Record was completed on (mo/day/year) **06/29/10**..... under the business name of **Kelly's Water Well Service, Inc.**..... by (signature) *Kathryn L. Bond*.....

INSTRUCTIONS: Use typewriter or ball point pen. PLEASE PRESS FIRMLY and PRINT clearly. Please fill in blanks and check the correct answers. Send three copies (white, blue, pink) to Kansas Department of Health and Environment, Bureau of Water, Geology Section, 1000 SW Jackson St., Suite 420, Topeka, Kansas 66612-1367. Telephone 785-296-5522. Send one copy to WATER WELL OWNER and retain one for your records. Include fee of \$5.00 for each constructed well. Visit us at <http://www.kdheks.gov/waterwell/index.html>.



KANSAS DEPARTMENT OF HEALTH & ENVIRONMENT

ASSIGNMENT OF WATER WELL TO LANDOWNER

I, John Deweese of 1500 Broadway Ave.
(Landowner's address)

Great Bend Kansas 67530 am the landowner on which a water well is located in
(City) (State) (Zip)
the SE quarter of the NW quarter of the SE quarter in Section 33, Township 21,
Range 13 E W, in Stafford County, Kansas which is approxi-
mately 1350 feet north/south, and 1750 feet east/west of the apparent SE
section corner. The water well was drilled in July 2010 (month/year).

I hereby request that Charter Energy, Inc. leave the water well,
(Operator name)

which was drilled by Temporary Water Permit # 20100261 00, unplugged, and I will
assume all responsibility for the plugging of said water well in accordance with the requirements
of the Kansas Department of Health and Environment regulation K.A.R. 28-30-7.

LANDOWNER:

John F. Deweese 11/9/10
(Signature) POA & TIE (Date)

John F. Deweese, POA & TIE
(Print)

OPERATOR:

[Signature]
(Signature) (Date)

By: _____
(Agent)

IF ADDITIONAL LANDOWNER

(Signature) (Date)

(Print)

WWC-7

RECEIVED
NOV 15 2010
BUREAU OF WATER